T.7S.R.5W.WM

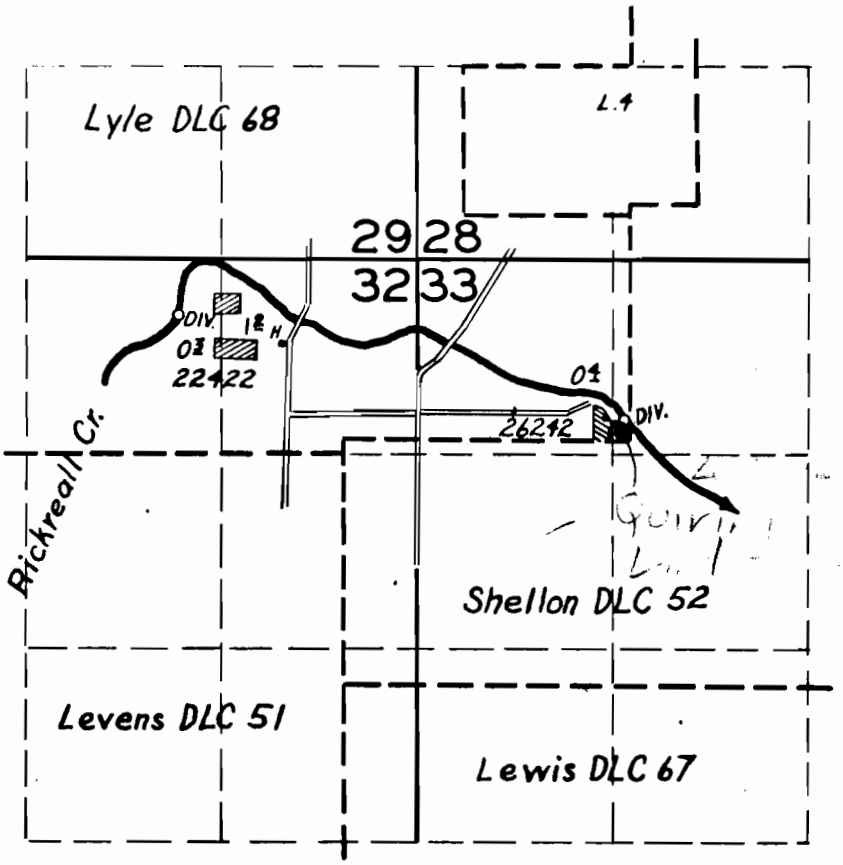

FINAL PROOF SURVEY

UNDER

Application No. ~~25242~~ 22422 Permit No. ~~20995~~ 17706

IN NAME OF

John J. Fidler

George F. McRae

Surveyed Aug. 17 19 54, by T. Jones

FP-2 -198