


T.6S. R.8W. W.M.

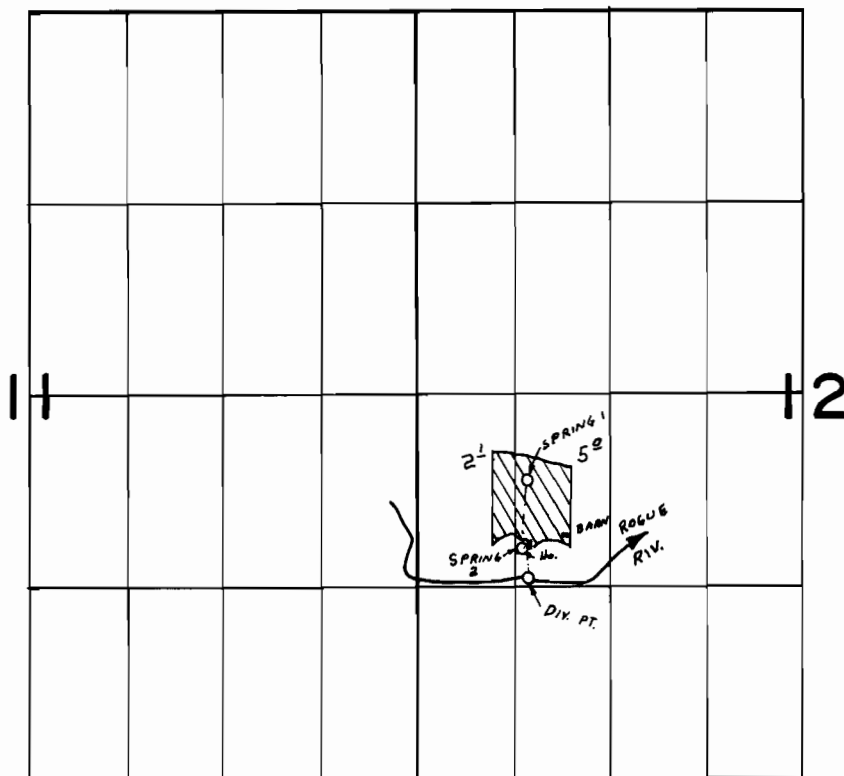

SPRING 1 LOC. 710' N & 760' E,
SPRING 2 LOC. 250' N & 720' E,
DIV. PT. LOC. 40' N & 770' E, ALL FROM
SW COR., W1/2, NW1/4, SW1/4, SEC. 12

FINAL PROOF SURVEY UNDER

Application No. 49298 Permit No. 36517
IN NAME OF

DORA ROSE CURL

Surveyed JUN 14 1974, by LH NUNN