


T.3 S. R.40 E. W.M.

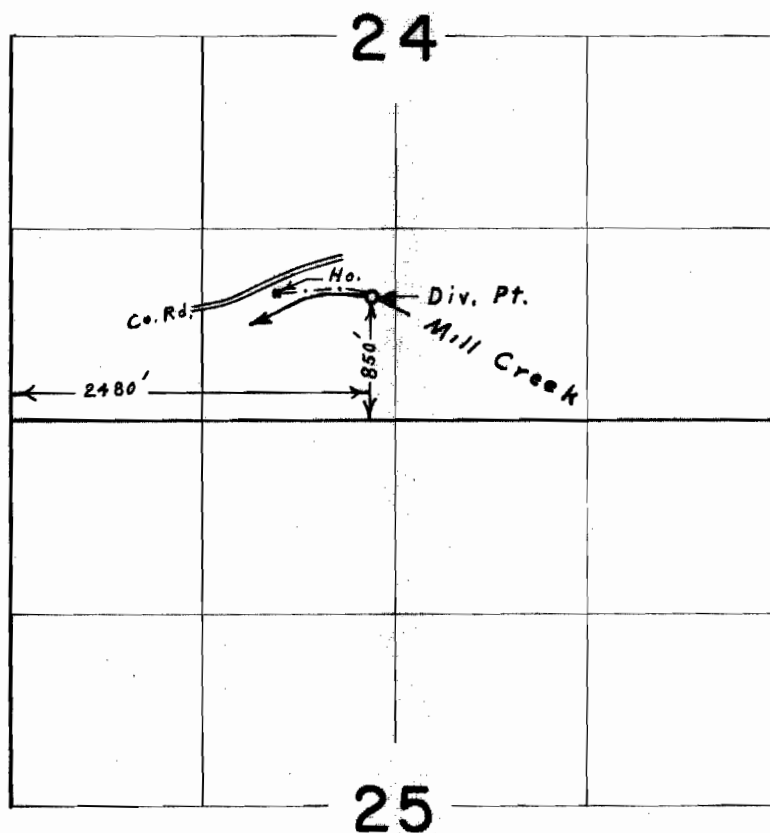

FINAL PROOF SURVEY
UNDER

Application No. 44931 Permit No. 33581
IN NAME OF

KAREN CAMPBELL

Surveyed Sept. 17, 1974, by L. E. Gould