


T.2 S. R.38 E. W.M.

13

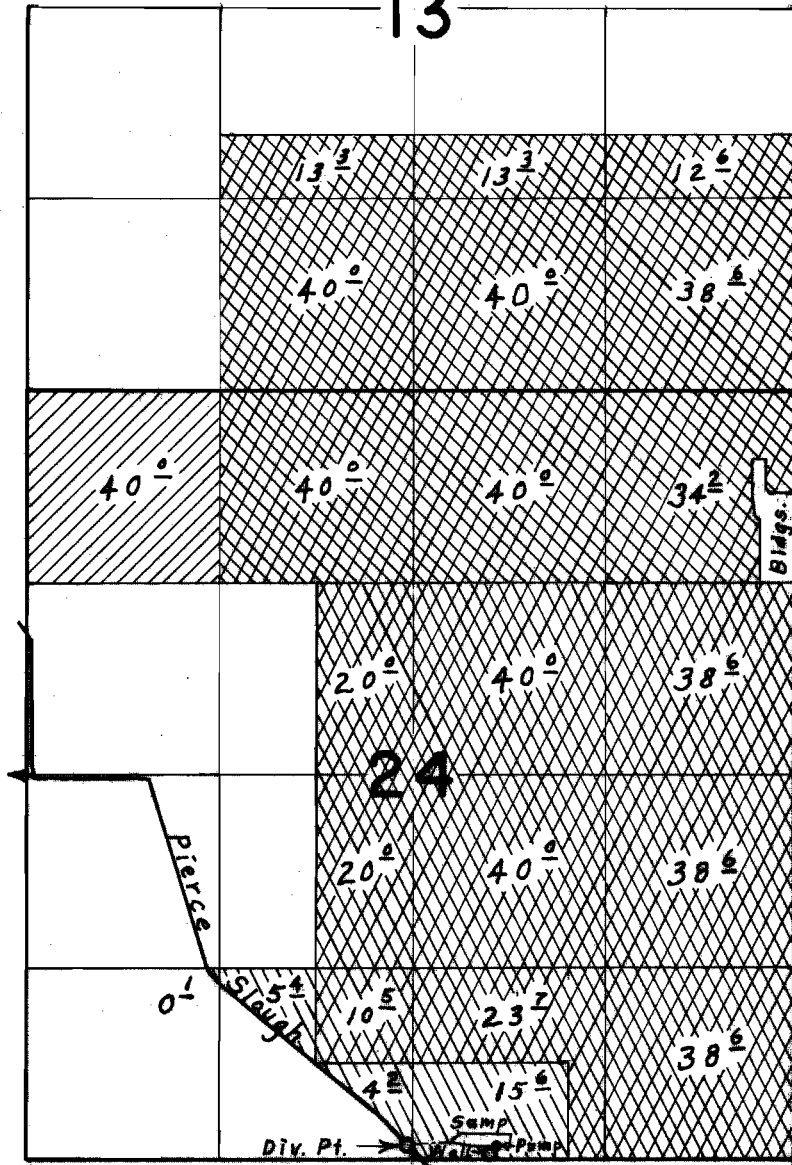

Div. Pts. located: Slough, 90° N. & 262.0' E.; Sump, 130' N. & 315.0' E.; Well, 30' N. & 318.0' E.; all from S.W. Cor. Sec. 24

FINAL PROOF SURVEY

UNDER

G-5102
45694
G-4754

G-4813
34088
G-4471

Application No. 43754 Permit No. 32698

IN NAME OF

PHILLIP T. & DOROTHY JEAN CUTHBERT

Surveyed Sept. 11, 1974, by L. E. Genld.

Primary

Supplemental

