


T.2N.R.14E.W.M.

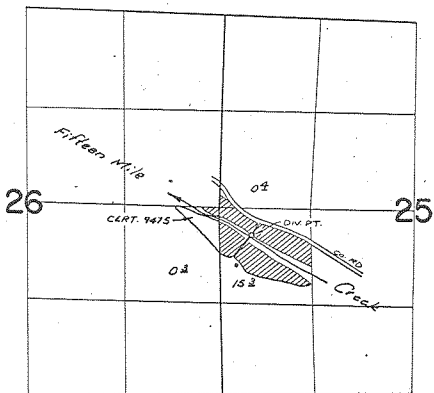

DIV. PT. LOC: 370'S. & 430'E. FROM W 1/4 COR. SEC. 25

FINAL PROOF SURVEY UNDER

Application No. 42103... Permit No. 31532...
IN NAME OF

ERIC A. JOHNSON

Surveyed APR. 24, 1974, by D. NORBY