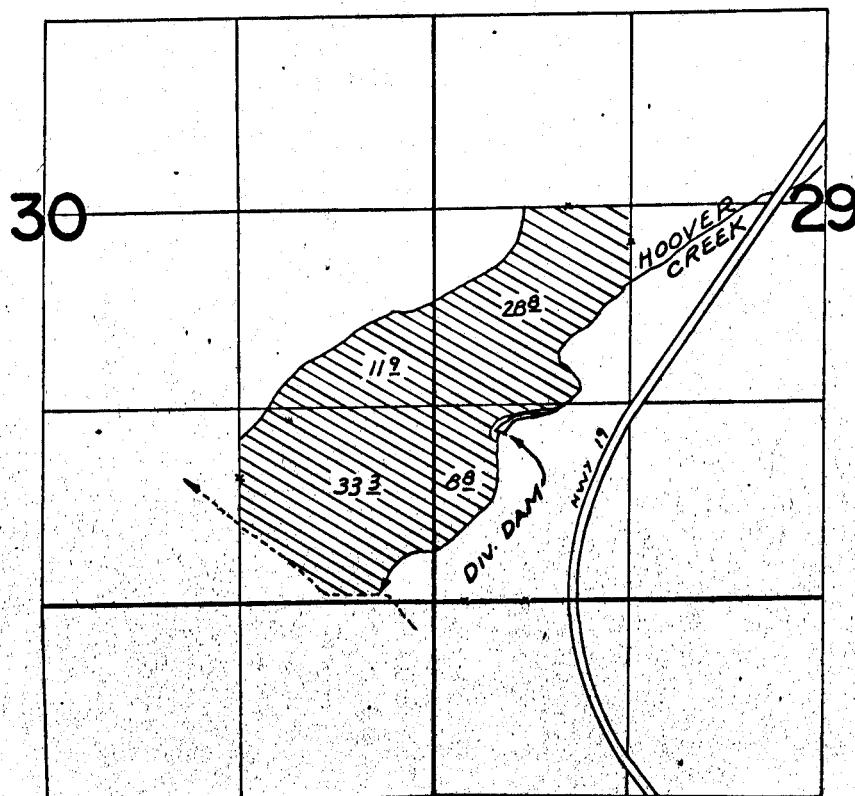


T.6S.R.21E.W.M.

DIV. PT. LOC. 1530' S. & 900' W. FROM N.E. COR. NW $\frac{1}{4}$ SW $\frac{1}{4}$ SEC. 29

FINAL PROOF SURVEY

UNDER

Application No. 41609 Permit No. 31031
IN NAME OF

LYLE R. OSTRANDER

Surveyed JULY 16, 1974, by R. MUCKEN