


T.5S. R.7W. W.M.

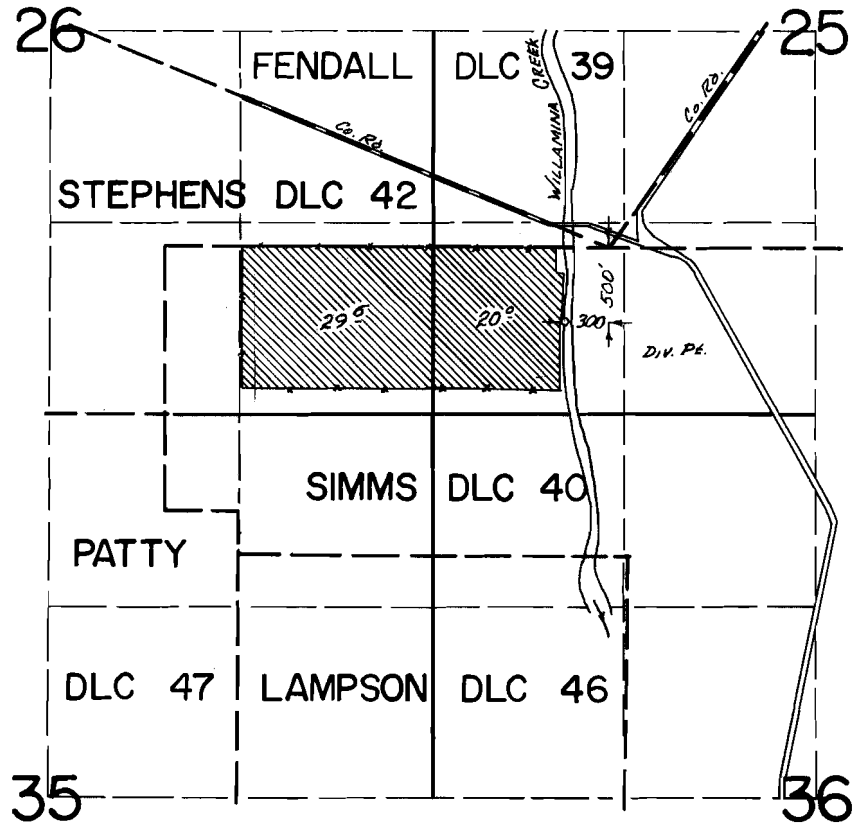

FINAL PROOF SURVEY
UNDER

Application No. 40673... Permit No. 30298...
IN NAME OF

.....TODD V. GUSTAFSON.....

Surveyed Oct. 9, 1974, by T. J. PAUL.....