


T.3 S. R.5 W. W.M.

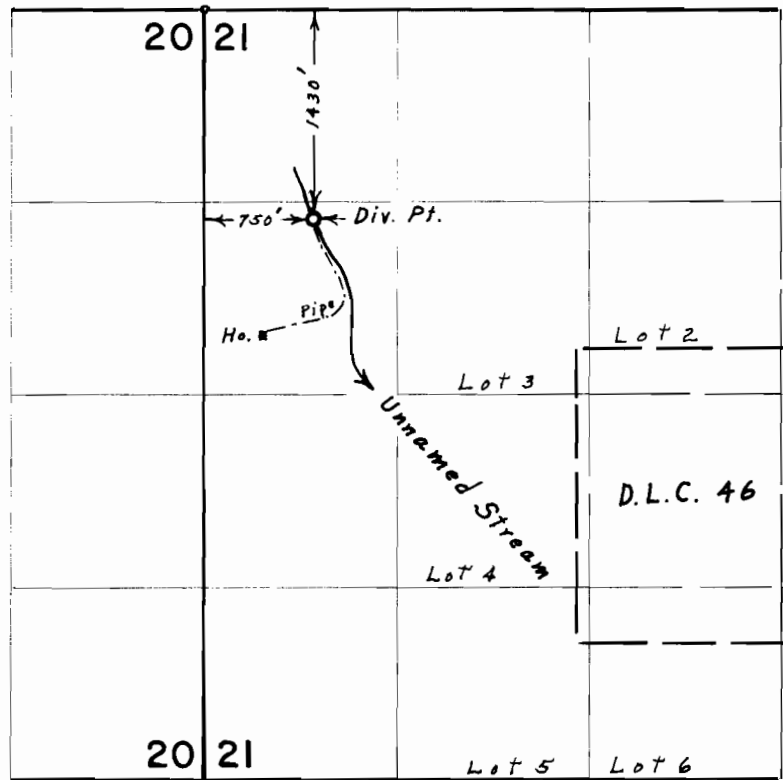

FINAL PROOF SURVEY
UNDER

Application No. 47130 Permit No. 34880
IN NAME OF

ORVILLE R. WEST

Surveyed May 29 1974, by L. E. Gould