


T.14S., R.6W., W.M.

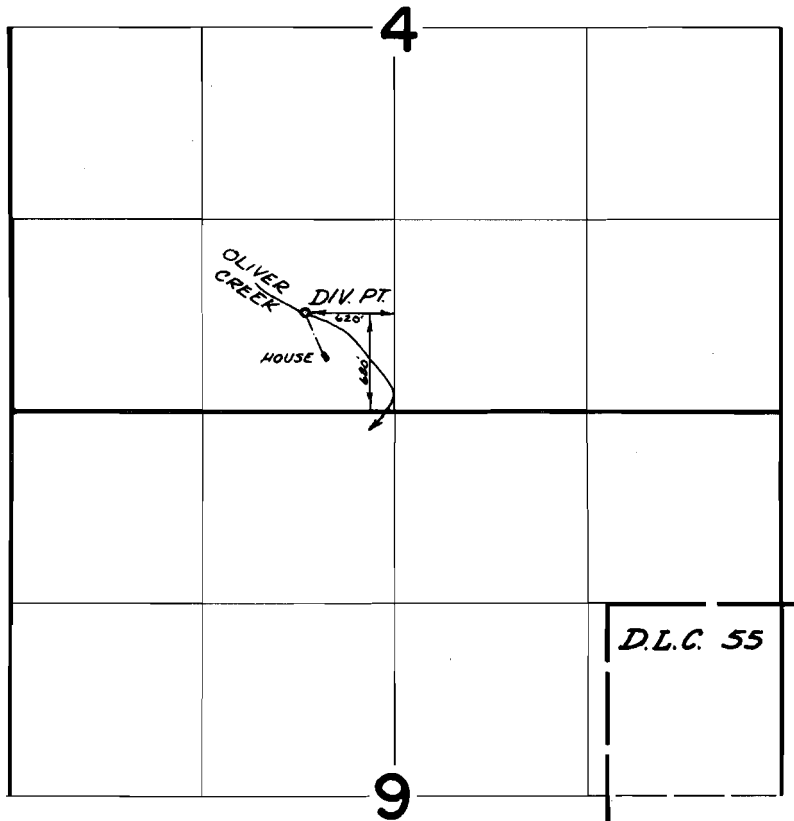

FINAL PROOF SURVEY
UNDER

Application No. 44473 Permit No. 33264

IN NAME OF

ELLIS L. & BETTY J. CONN

Surveyed JUNE 6 1973, by D. NORBY