T. 10 S. R. 3 W. W.M.

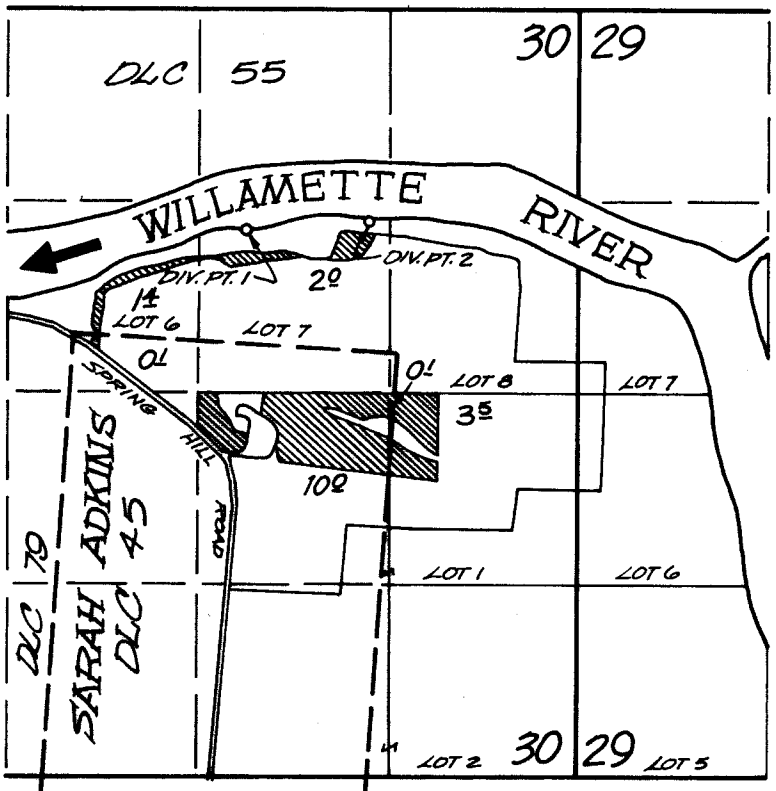

DIV. PTS. LOCATED; 1, 840' N. & 1060' W., 2, 910' N. & 200' W., BOTH FROM N.E. COR. ADKINS DLC 45.

FINAL PROOF SURVEY
UNDER

Application No. 46063 Permit No. 34501
IN NAME OF

DAVID W. & DONNA J. CLEM

Surveyed JULY 3 1974, by L.M. TOLL

DPU 2LL 212 CRK