


T.11S., R.6W., W.M.

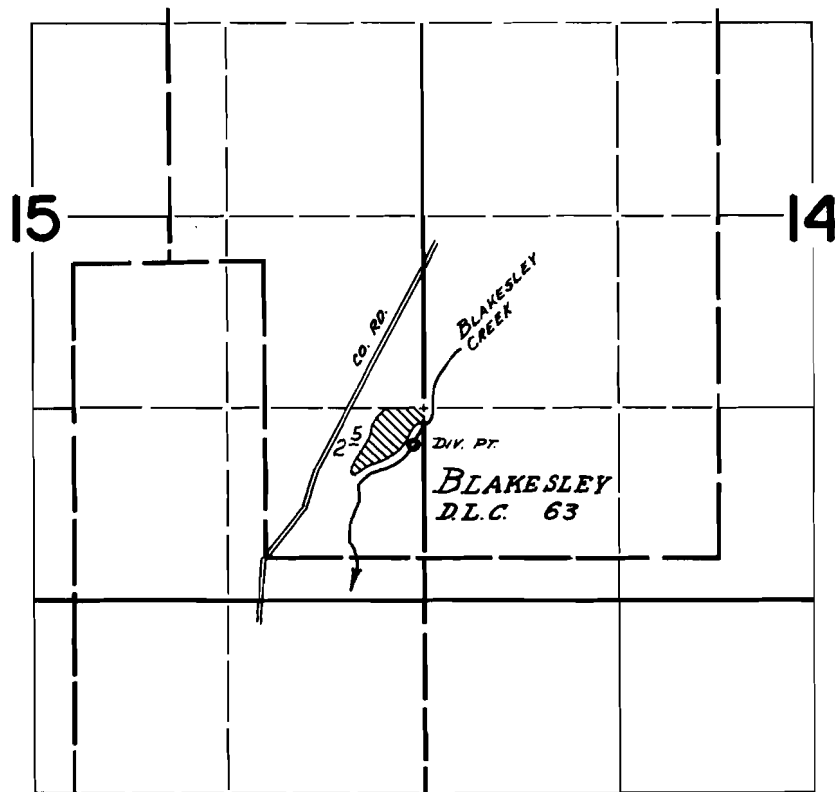

DIV. PT. LOCATED: 250'S & 70'W FROM NE COR. SE 1/4 SE 1/4 SEC. 15

FINAL PROOF SURVEY
UNDER

Application No. 46121..... Permit No. 34510.....
IN NAME OF

DONALD A. AND MARCIA A. GRIFFIN

Surveyed August 21 1973, by D. Norgy