


# T. 11 S. R. 6 W. W. M.

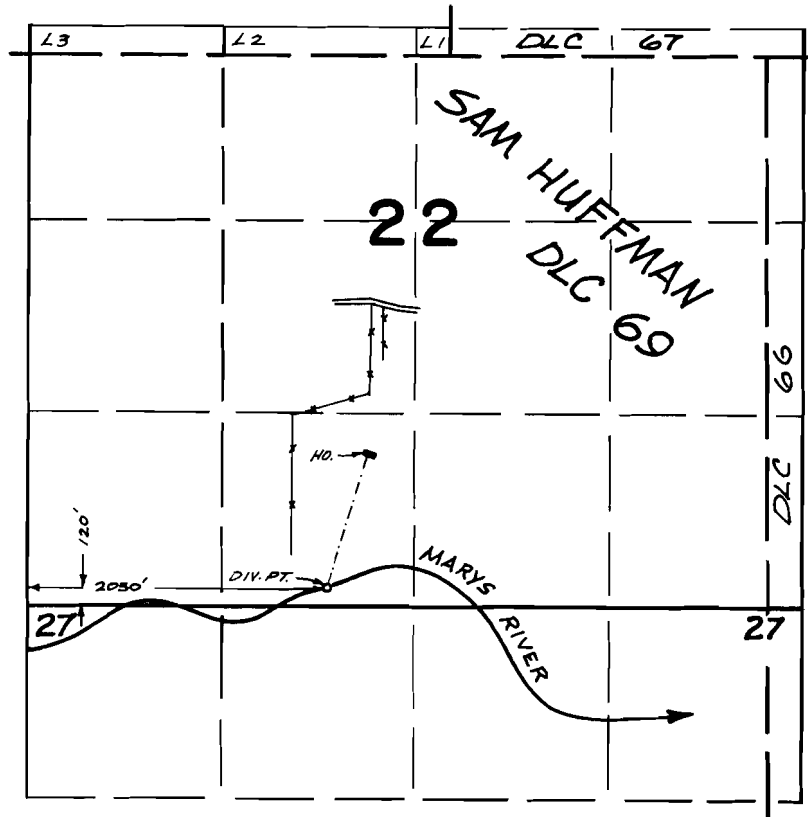

## FINAL PROOF SURVEY UNDER

Application No. 46230 Permit No. 34540  
IN NAME OF

WILLIAM T. SCHULZ

Surveyed NOV. 5 1974, by L.M. TOLL