




# T.5 S. R.1 W. W.M.

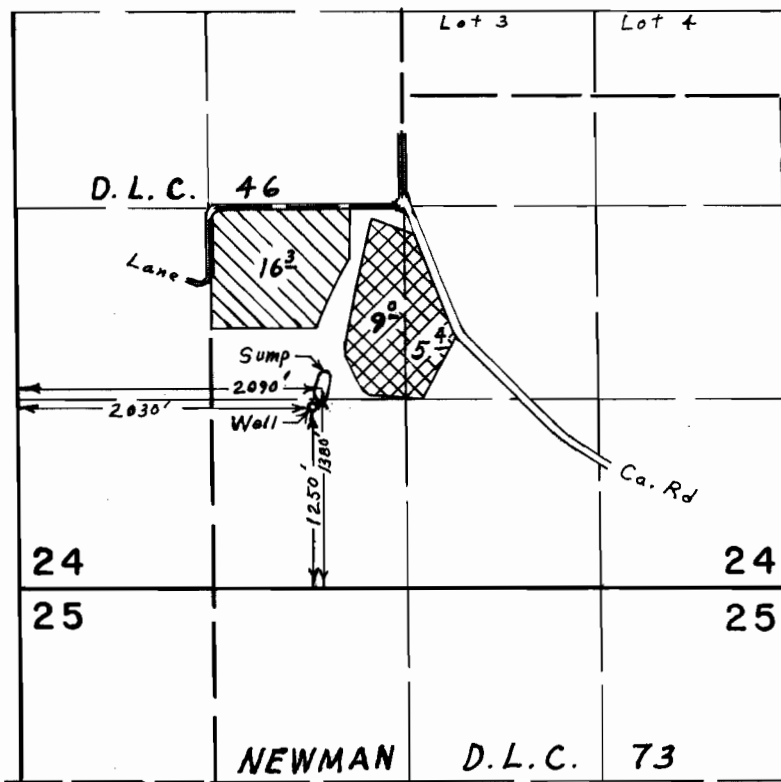

Supplemental Irrig.   
 Frost Control 

## FINAL PROOF SURVEY UNDER

Application No. G-4004 Permit No. G-3756  
 IN NAME OF  
**ROSS IVERSON**

Surveyed June 19, 1974, by L. E. Gould