


T.2S. R.4E. W.M.

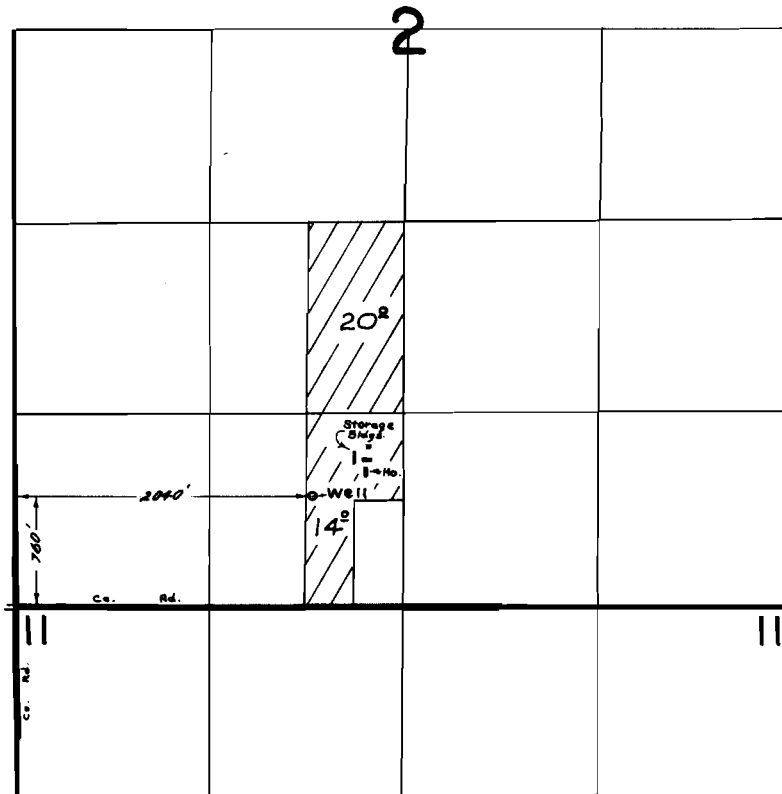

FINAL PROOF SURVEY

UNDER

Application No. G-4199 Permit No. G-3964
IN NAME OF

HARRY G. & FLORENCE CHATELAIN

Surveyed NOV. 7, 1974, by L.E. GOULD