


T.5S. R.1E. W.M.

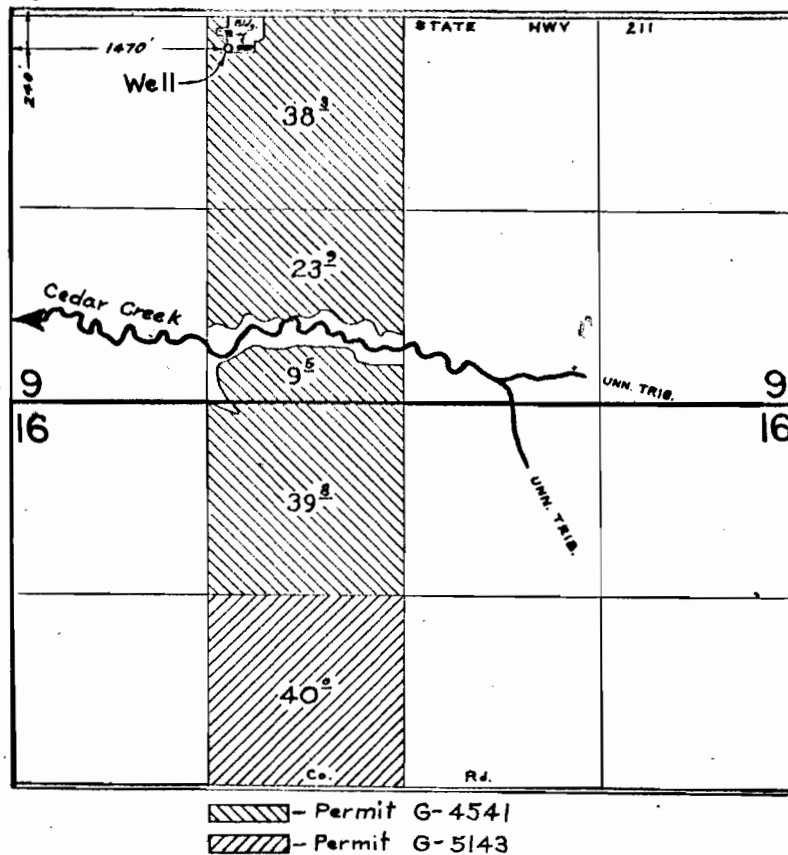

FINAL PROOF SURVEY
UNDER

Application No. G-4822 G-5320 Permit No. G-4541 G-5143
IN NAME OF

BRONEC BROTHERS

Surveyed JULY 16, 1974, by L.E. GOULD

Ma