


T.2S. R.I.E. W.M.

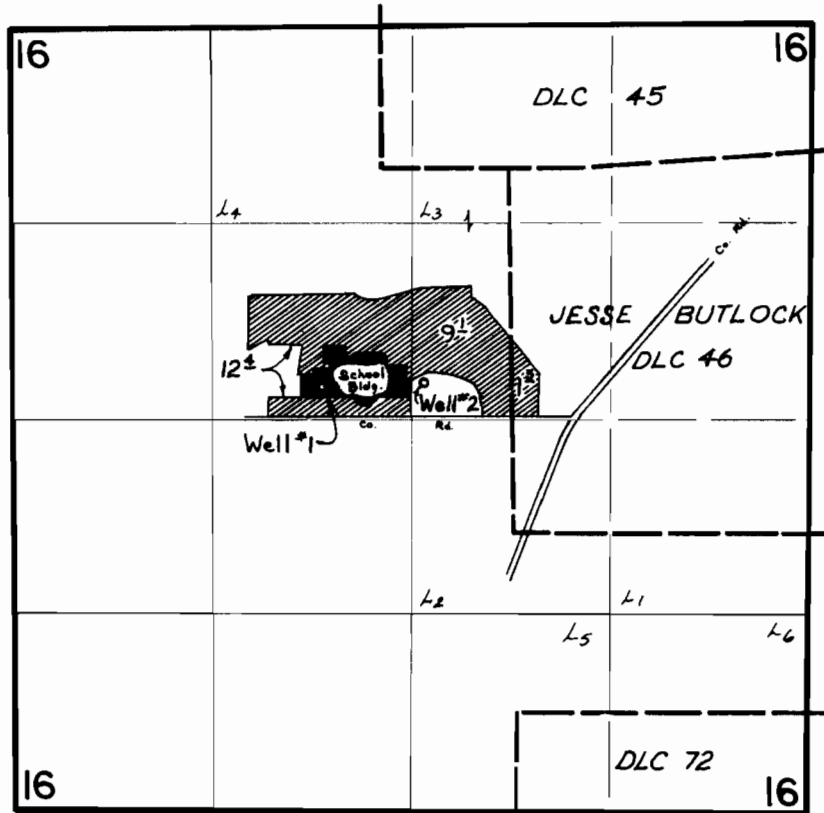

WELLS LOCATED: *1- 2910' N. AND 3180' E., *2- 2940' N. AND 2810' E. BOTH FROM SW. COR. SEC. 16

FINAL PROOF SURVEY UNDER

Application No. G-4951 Permit No. G-4673
IN NAME OF

LAKE OSWEGO SCHOOL DISTRICT

Surveyed SEPT. 4, 1974, by L.E. GOULD