


T.5S. R.1E. W.M.

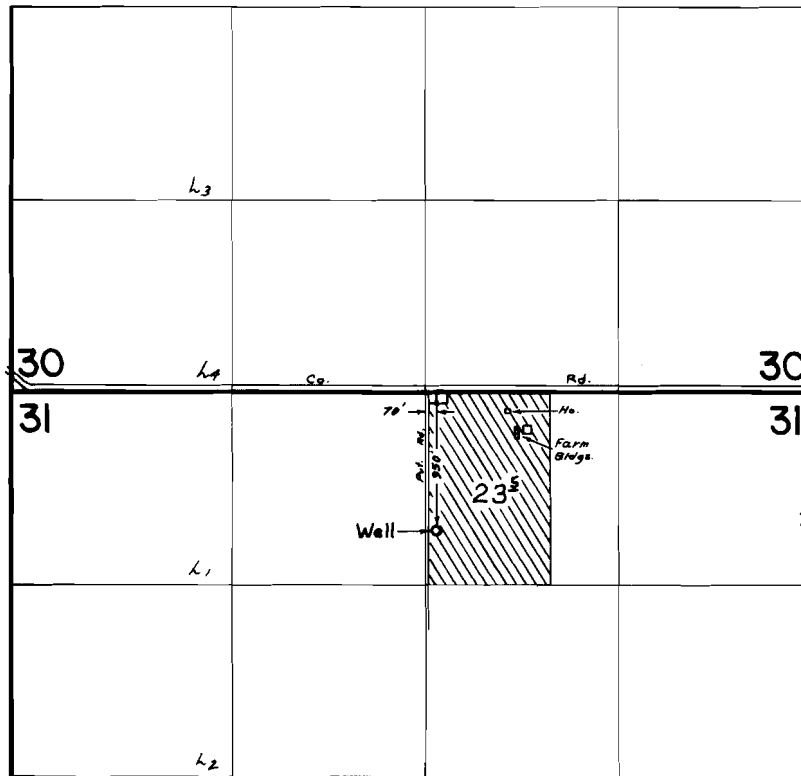

FINAL PROOF SURVEY UNDER

Application No. G-5591 Permit No. G-4980
IN NAME OF

WARREN E. HATCHER

Surveyed JULY 16, 1974, by L.E. GOULD