


T.4S.R.1E.W.M.

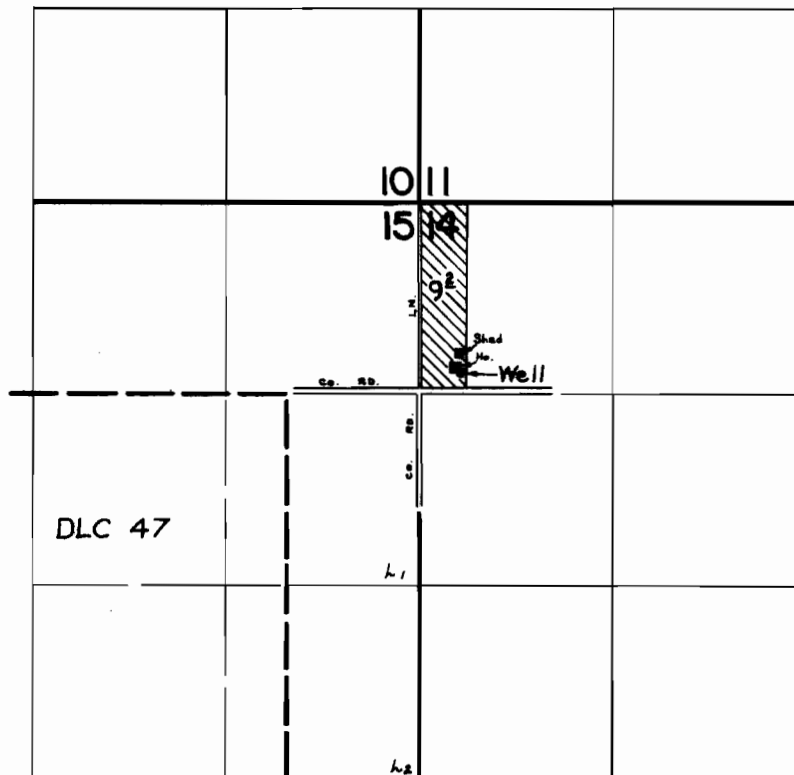

DIV. PT. LOC.: 1180' S. & 290' E. FROM N.W. CORNER SECTION 14

FINAL PROOF SURVEY
UNDER

Application No. G-6012 Permit No. G-5176
IN NAME OF

LEWIS SIRI

Surveyed JULY 18, 1974, by L.E. GOULD