


T.4S. R.2E. W.M.

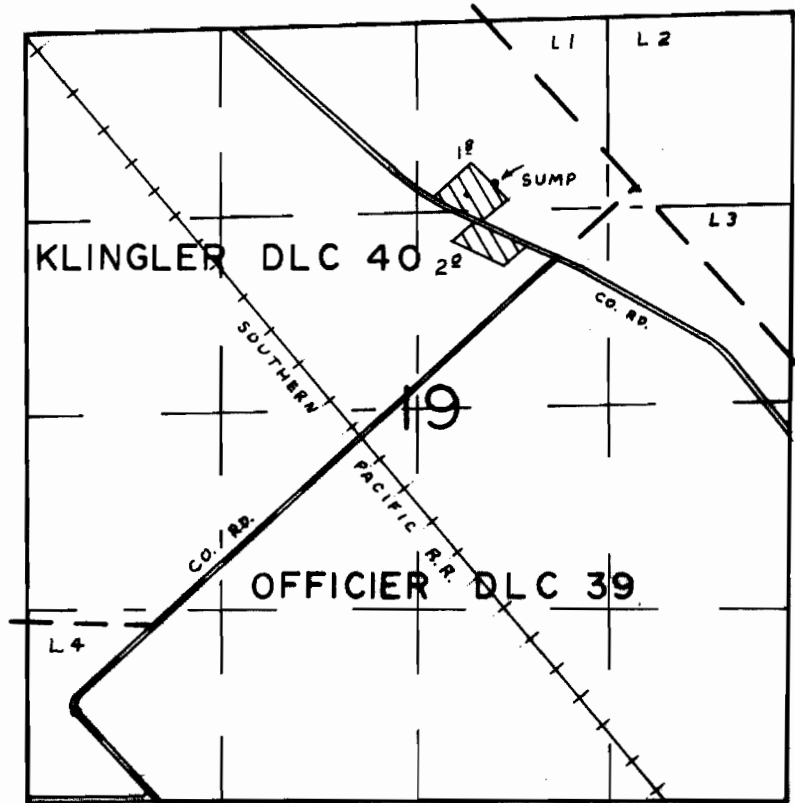

SUMP LOC. 20' N. & 990' W. FROM N. COR. DLC 39

FINAL PROOF SURVEY
UNDER

Application No. G: 5.7.5.2 Permit No. G: 5.5.3.8
IN NAME OF

VEYBART Q ZUMWALT

Surveyed JUL 30 1975, by D. NORBY