


T.2S. R.4E. W.M.

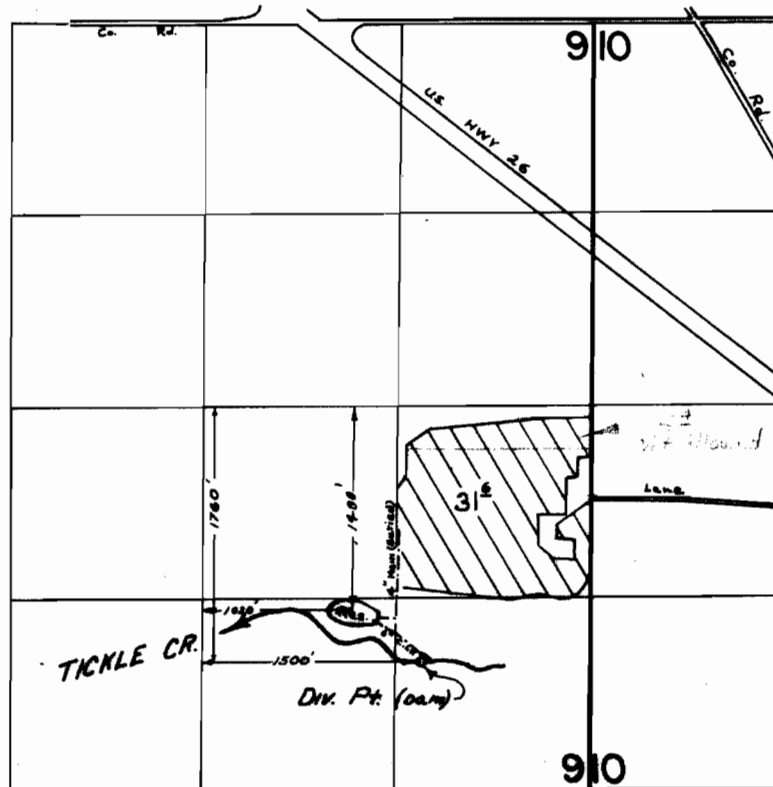

FINAL PROOF SURVEY
UNDER

Application No. 42666 Permit No. 31886
IN NAME OF R-42665 R-4843

RICHARD WELDEN

Surveyed NOV. 8, 1974, by L. E. GOULD