


T.2S.R.4E.W.M.

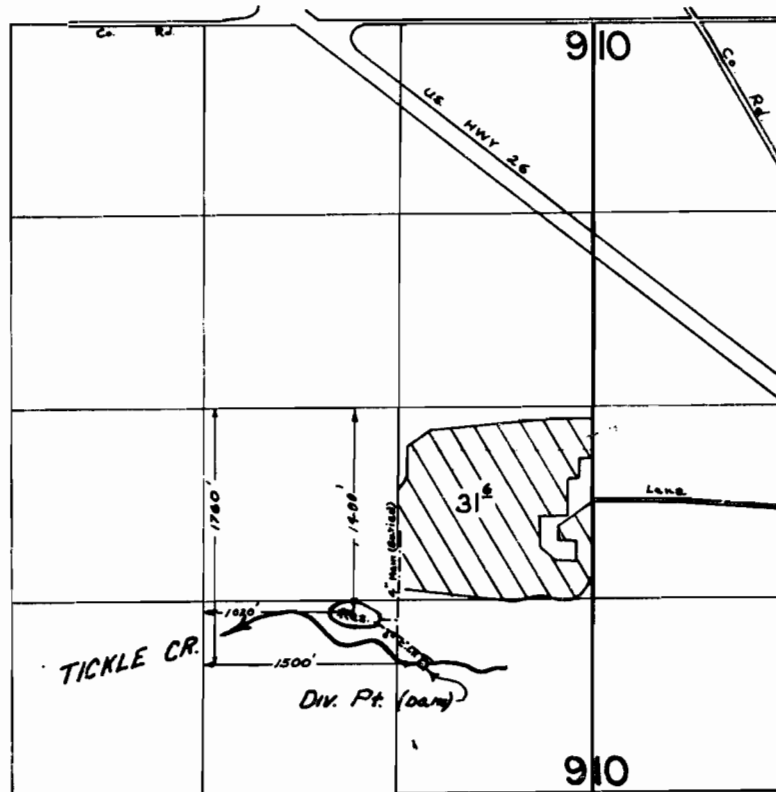

FINAL PROOF SURVEY
UNDER

Application No. 42666 Permit No. 31886
R-42665 R-4843
IN NAME OF

RICHARD WELDEN

Surveyed NOV. 8, 1974, by L.E. GOULD