


T.2S. R.38&4E. W.M.

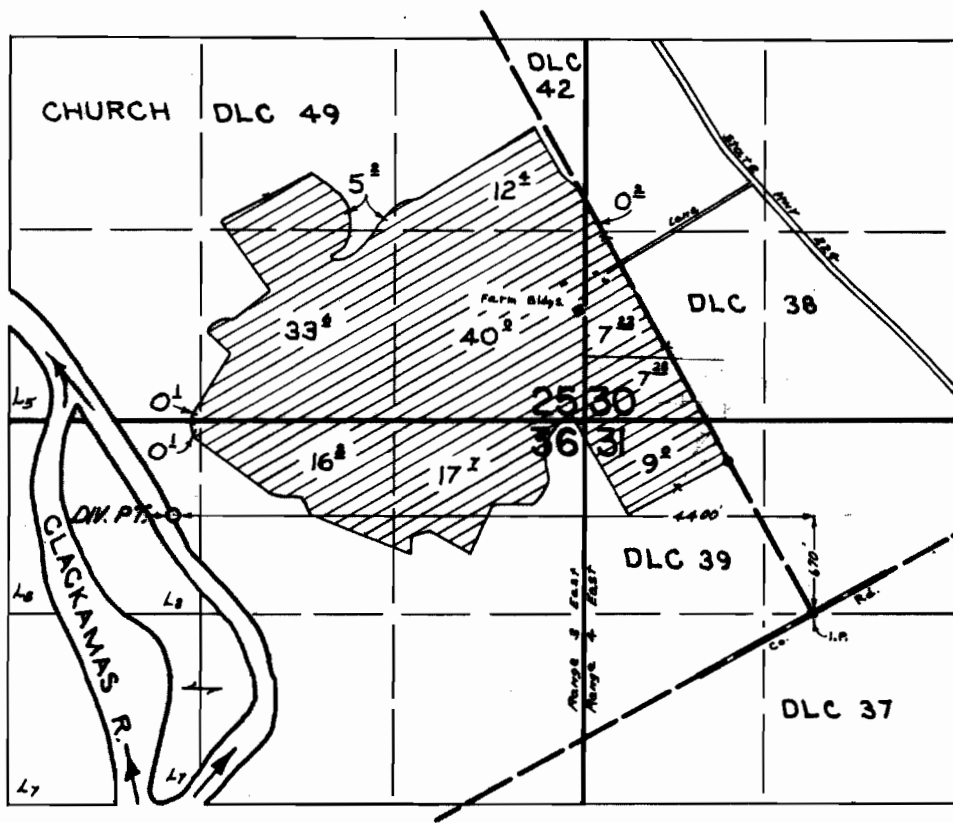

FINAL PROOF SURVEY
UNDER

Application No. 43045 Permit No. 31949
IN NAME OF

LELAND L. & EDNA M. BARGER

Surveyed NOV. 6, 1974, by L. E. GOULD