


T.28&3S. R.3E. W.M.

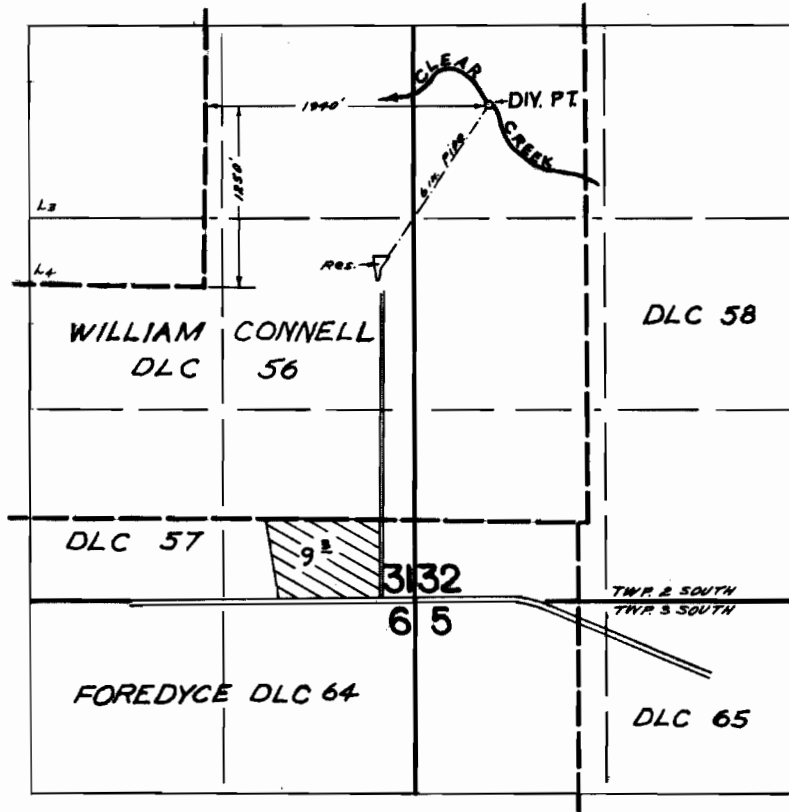

FINAL PROOF SURVEY
UNDER

Application No. 45350 Permit No. 33862
IN NAME OF

ESTATE OF JOHN DEININGER

Surveyed OCT. 1, 1974, by L. E. GOULD