


T.182S. R.1E. W.M.

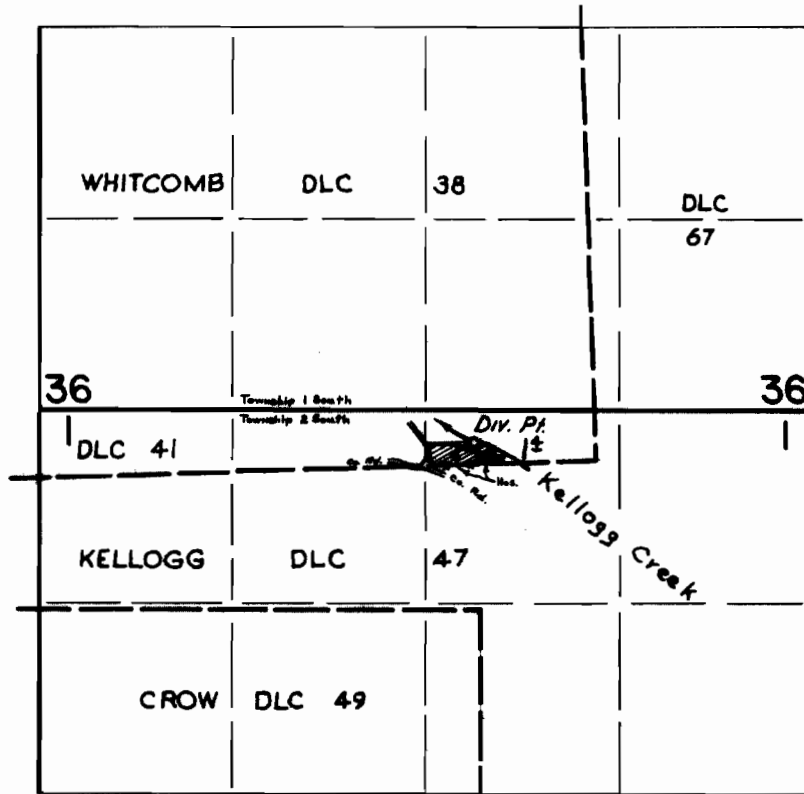

DIV. PT. LOC: 120' N. AND 830' W. FROM S.E. COR. WHITCOMB DLC 41

FINAL PROOF SURVEY UNDER

Application No. 49103 Permit No. 36722
IN NAME OF

GORDON A. & CONSTANCE E. CROOKS

Surveyed SEPT. 5, 1974, by L.E. GOULD