


T. 26 S. R. 7 W. W.M.

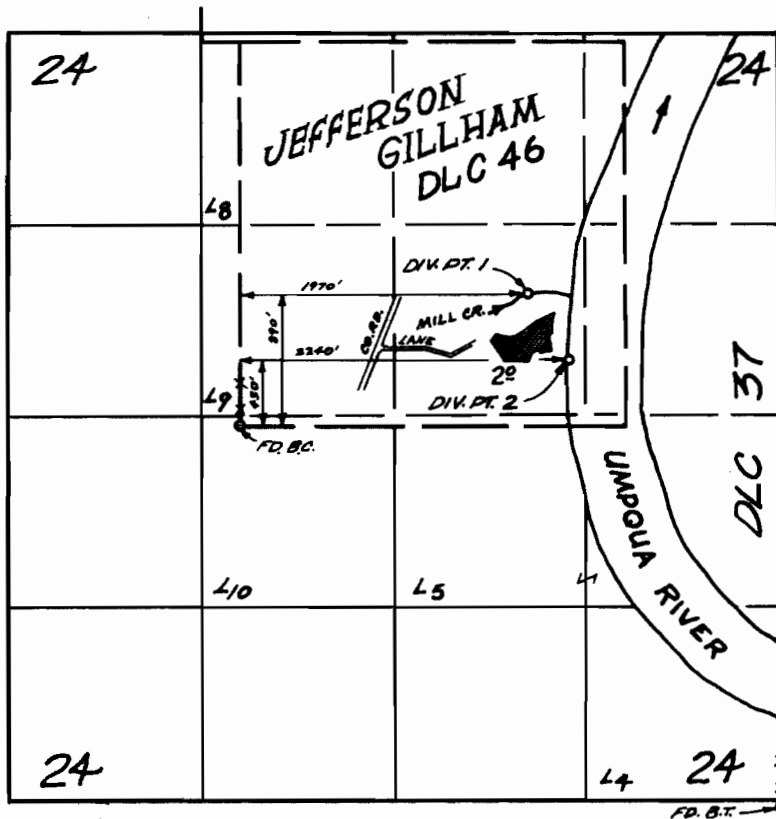

**FINAL PROOF SURVEY**  
UNDER

Application No. 15920 Permit No. 34308  
IN NAME OF

EVERETT MOODY

Surveyed AUGUST 21 1974, by L.M. TOLL