


T.33S. R.6W. W.M.

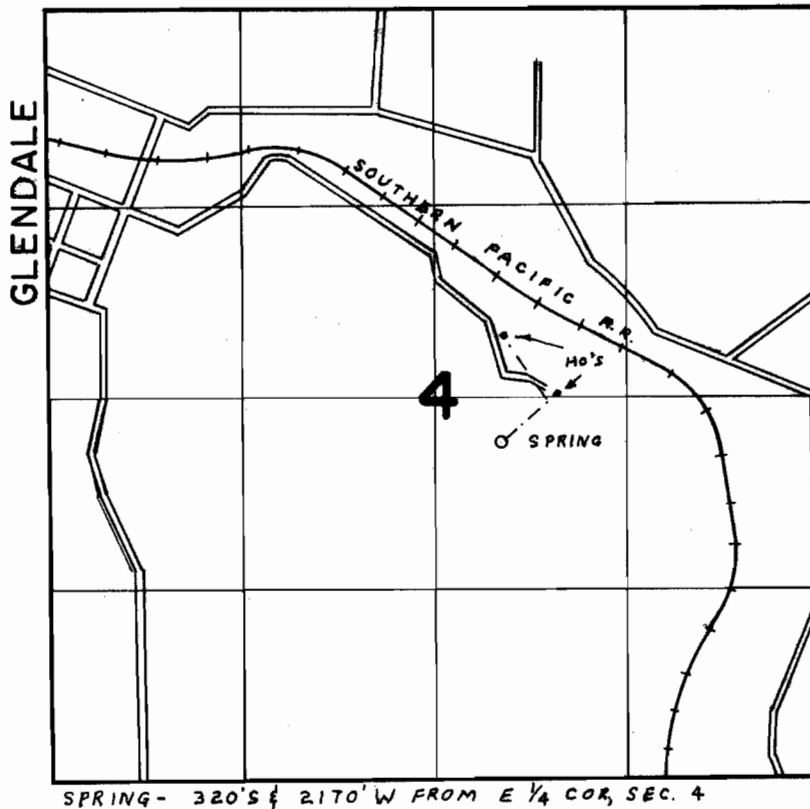

FINAL PROOF SURVEY
UNDER

Application No. 48116 Permit No. 36131
IN NAME OF

HANS TRESCHER

Surveyed JUL 10 1974, by LH NUNN