


T.25S. R.7W. W.M.

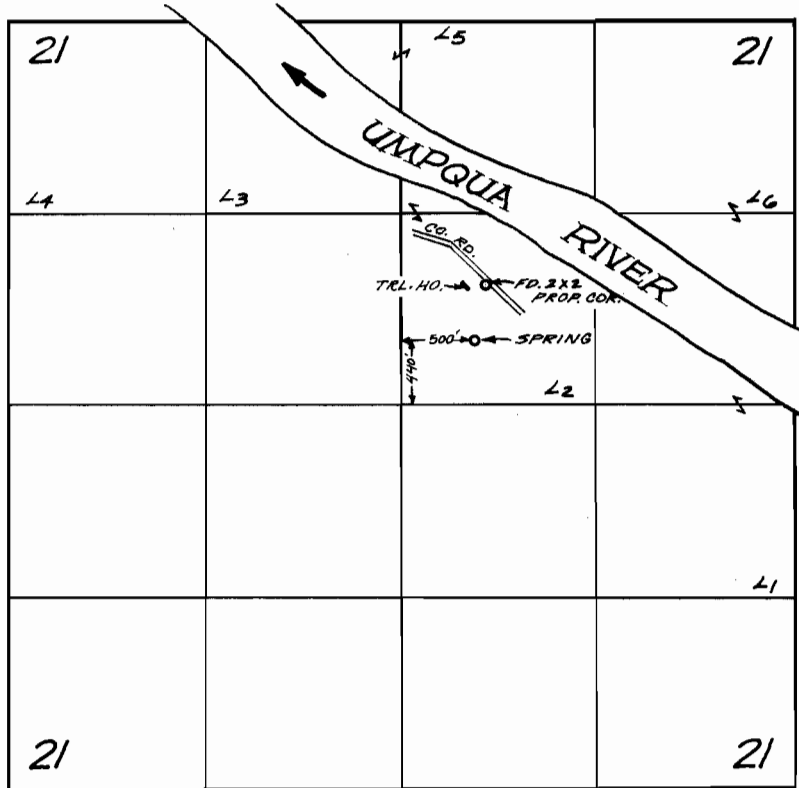

**FINAL PROOF SURVEY**  
UNDER

Application No. 48512 Permit No. 36398  
IN NAME OF

*DALE E. & MILDRED M. JUDD*

Surveyed AUGUST 20 1974, by L.M. TOLL