


T.3N., R.11E., W.M.

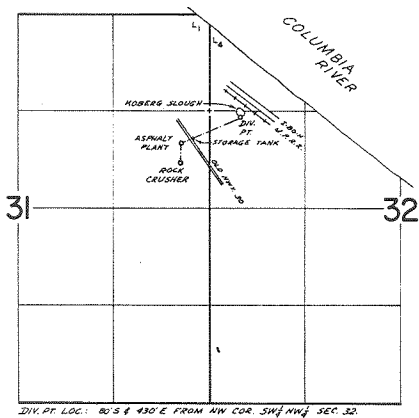

FINAL PROOF SURVEY
UNDER

Application No. 49255 Permit No. 36915
IN NAME OF

J. ARLIE BRYANT, INC.

Surveyed April 17, 1975, by D. Norby