


T.36S. R.2W. W.M.

T.36S. R.1W. W.M.

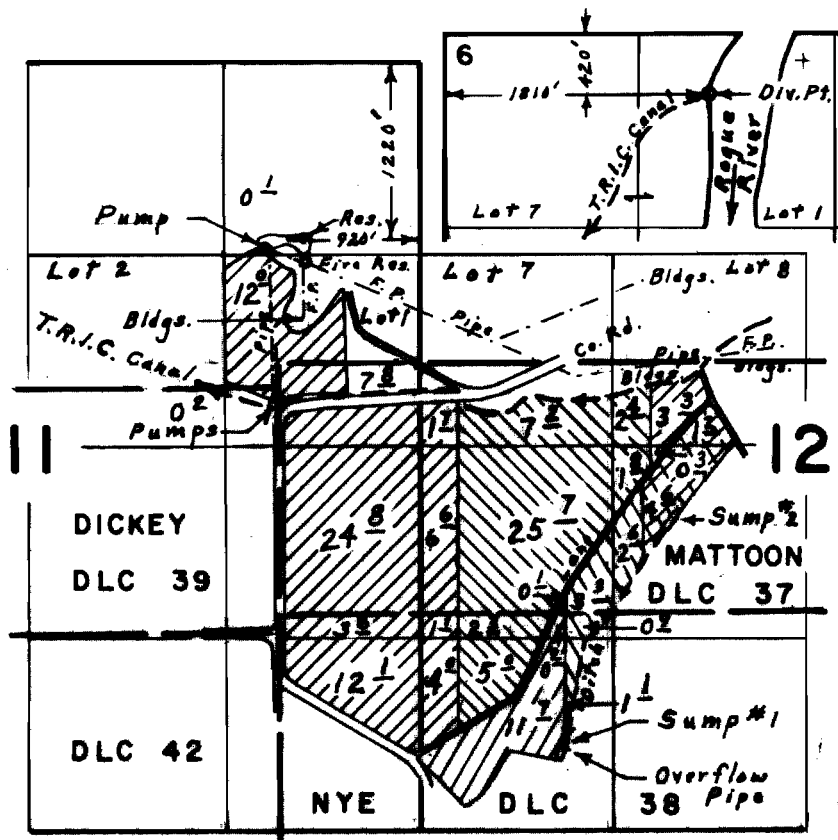

Sump #1: 750' S, 1940' E, Sump #2: 800' N, 2700' E both from NE cor. DIC. 42

FINAL PROOF SURVEY UNDER

G- 5740
49032
R- 47768

G- 4973
35934
R- 5767



Application No. 4.7.7.6.9 Permit No. 3.5.7.7.7

IN NAME OF

MODOC ORCHARD COMPANY

Surveyed Sept. 26 1973, by L. E. Gould