


T.37S. R.7W. W.M.

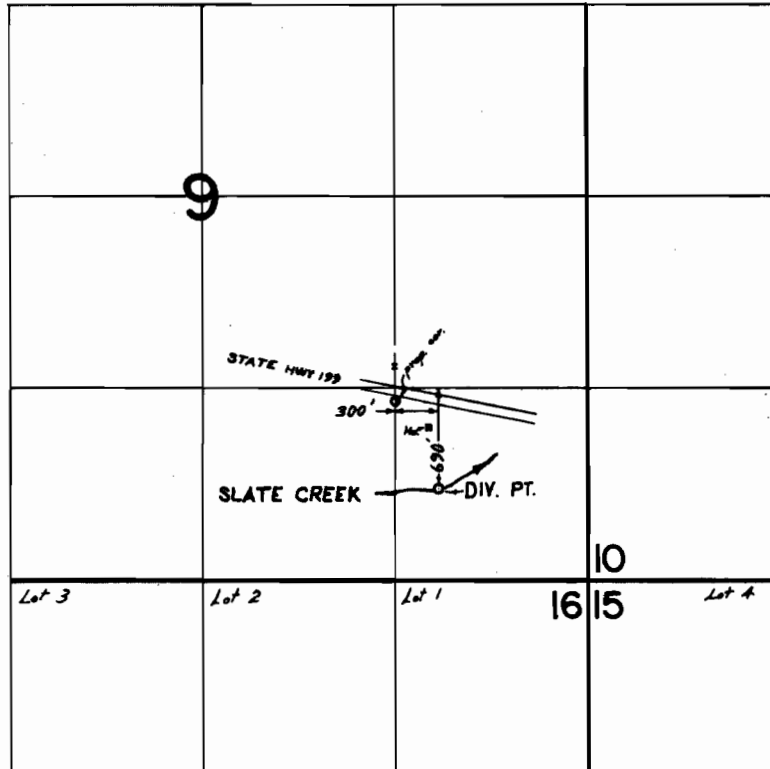

FINAL PROOF SURVEY
UNDER

Application No. 48728 Permit No. 36553
IN NAME OF

ALLEN B. STEDMAN

Surveyed MAY 21, 1974, by L. E. GOULD