


T.37&38S., R.111/2E., W.M.

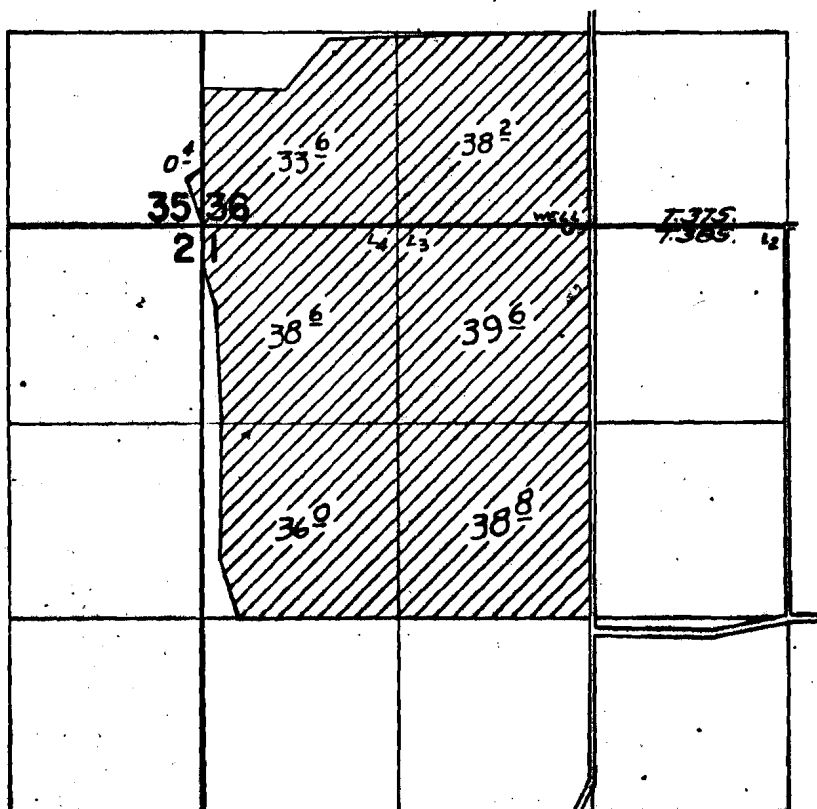

WELL LOCATED: 10' S & 40' W FROM N 1/4 COR. SEC. 1.

FINAL PROOF SURVEY UNDER

Application No. G-3396 Permit No. G-3092
IN NAME OF

Robert V. & Marcella Walker

Surveyed Oct. 30 1974, by D.M. Norby