


T.33S. R.6E. W.M.

Withdrawn because of abandonment Jan. 22, 1972

Sevenmile Crk. Mec.

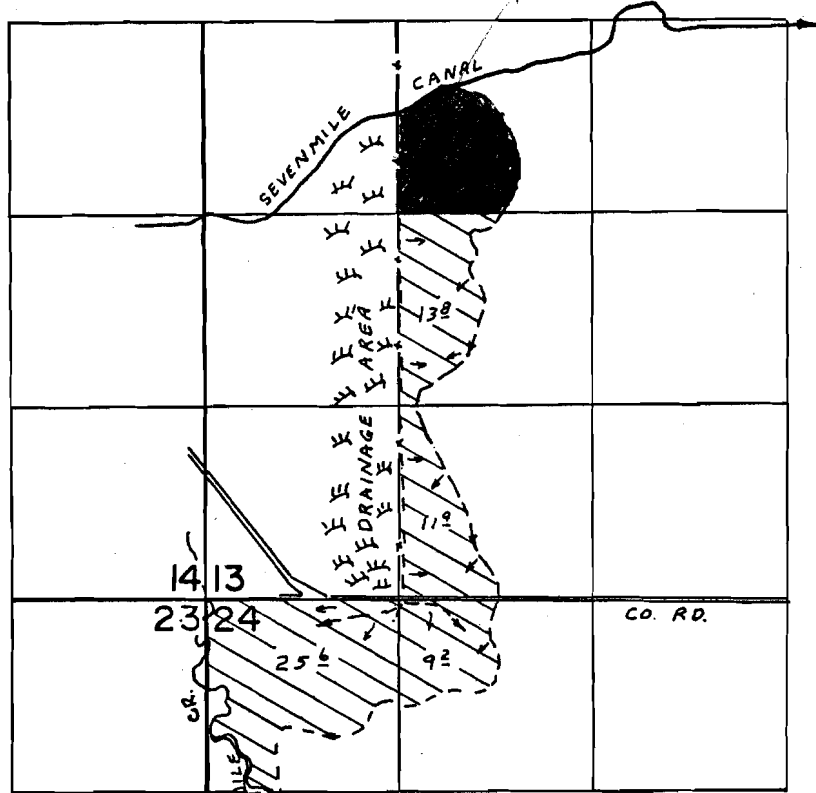

DRAINAGE COLLECTED IN DITCH BETWEEN POINTS 3320' N. & 20' N. BOTH FROM THE SW COR., SE 1/4 SW 1/4, SEC. 13.

FINAL PROOF SURVEY UNDER

Application No. 48724 Permit No. 35790
IN NAME OF

ANDREW & DOROTHY POPSON

Surveyed OCT. 19, 1974, by L.H. NUNN