


T.16S. R.7W. W.M.

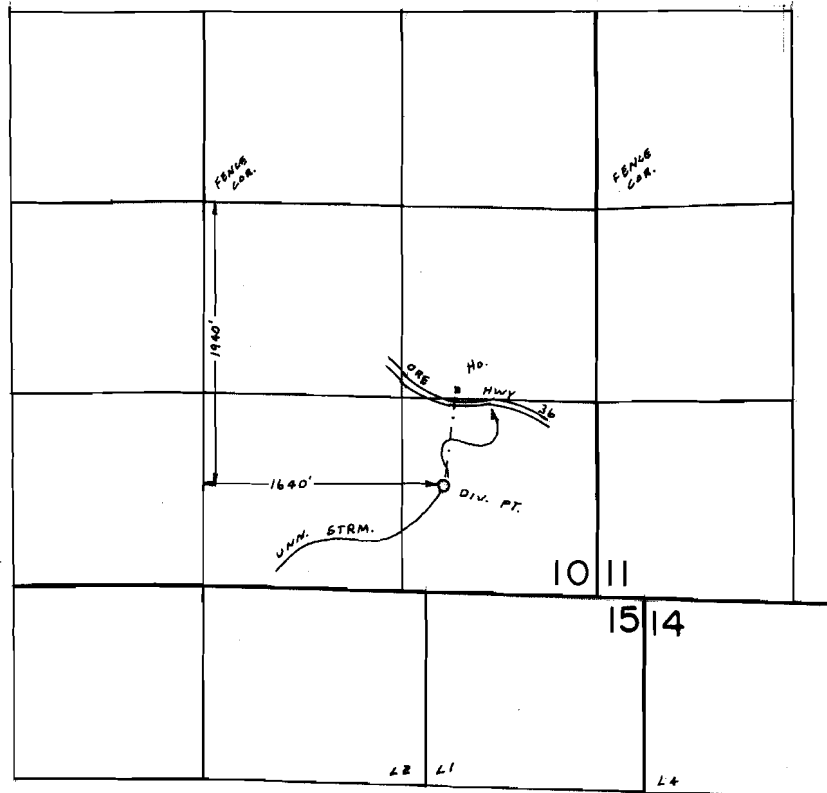

FINAL PROOF SURVEY
UNDER

Application No. 48370 Permit No. 36315
IN NAME OF

TOM JOHNSON

Surveyed OCT 31 1974, by L H NUNN