


T.13S. R.10W. W.M.

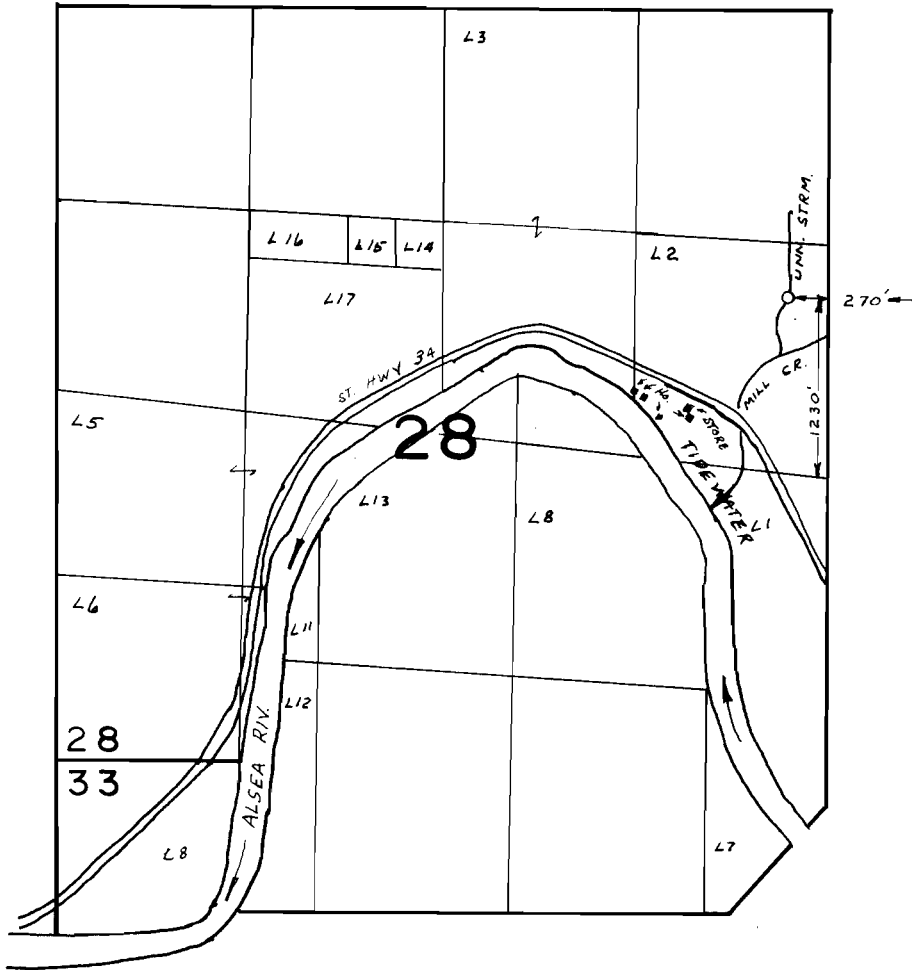

FINAL PROOF SURVEY
UNDER

Application No. 42021 Permit No. 31446
IN NAME OF

LEE E. WELTNER

Surveyed JUN. 6. 1974, by L.H. NUNN