


T.10S.R.8W.W.M.

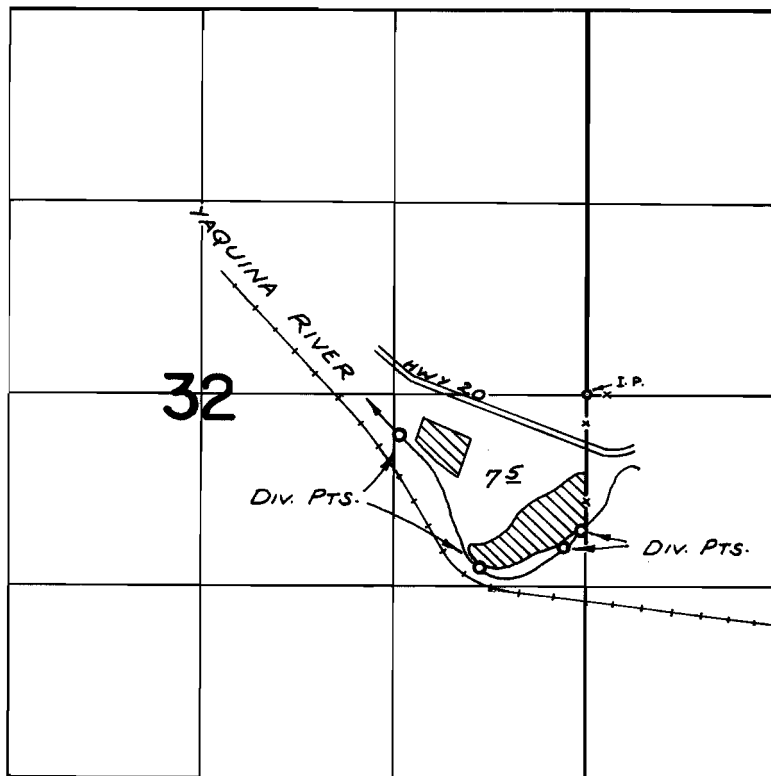

DIV. PTS. LOC: 930'S. & 30'W.; 1050'S. & 150'W.; 1180'S. & 730'W.;
280'S. & 1280'W.; ALL FROM E. 1/4 COR. SEC. 32

FINAL PROOF SURVEY UNDER

Application No. 44118 Permit No. 32954
IN NAME OF

N. HOMER EDWARDS

Surveyed SEPT. 29, 1974, by R. MUCKEN