


T. 6S. R. 10W. W.M.

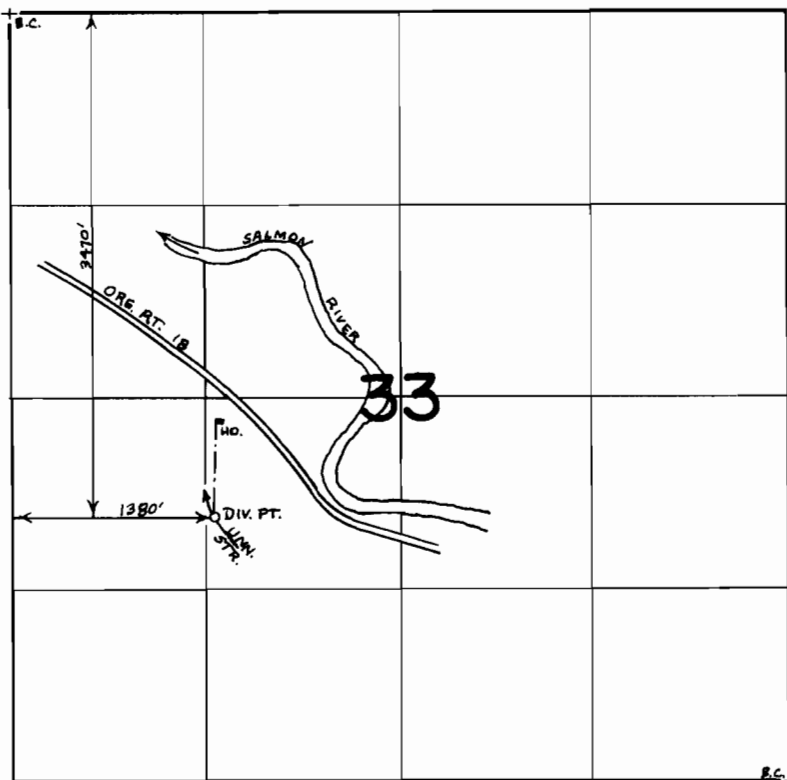

**FINAL PROOF SURVEY**  
UNDER

Application No. 46029 Permit No. 34127.....  
IN NAME OF

**JACK L. & BLANCHE L. HUBBARD**

Surveyed JULY 16 1974, by D. NORBY.....