


T.11S.R.8W.W.M.

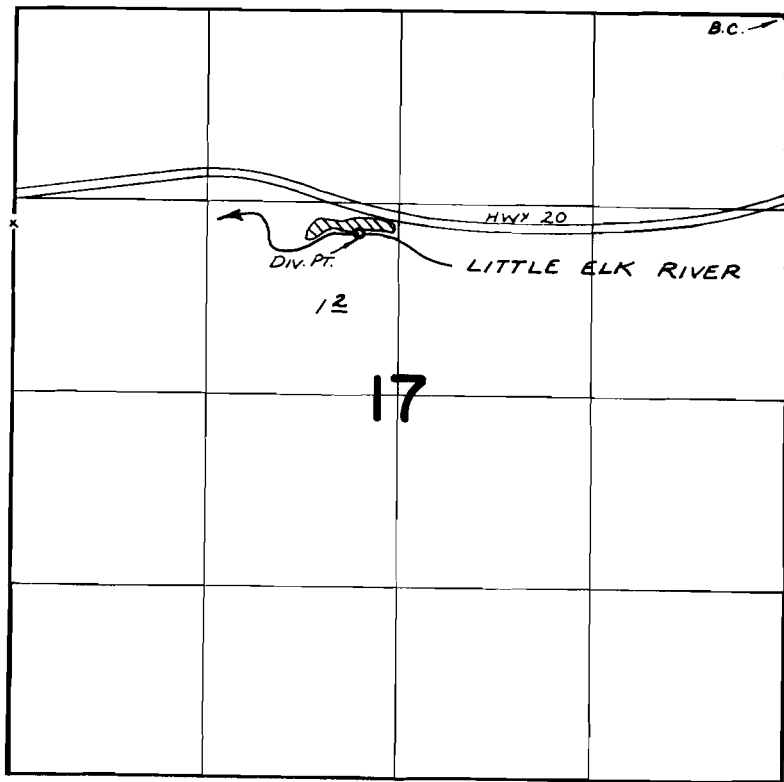

DIV. PT. LOC: 1530'S. & 2930'W. FROM N.E. COR. SEC. 17

FINAL PROOF SURVEY
UNDER

Application No. 46178 Permit No. 34337
IN NAME OF

DONALD E. HOPKINS

Surveyed SEPT. 29, 1974, by R. MCKEN