


T.13S. R.11W. W. M.

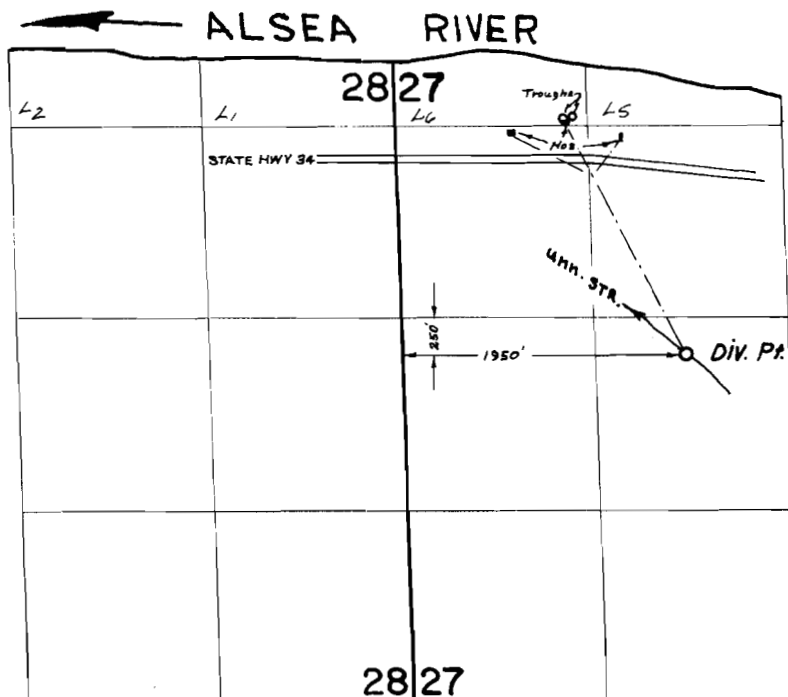

FINAL PROOF SURVEY
UNDER

Application No. 46288 Permit No. 34576
IN NAME OF

ELTON R. HOLT

Surveyed AUG. 19, 1974, by D. NORBY