


T.13S. R.11W. W.M.

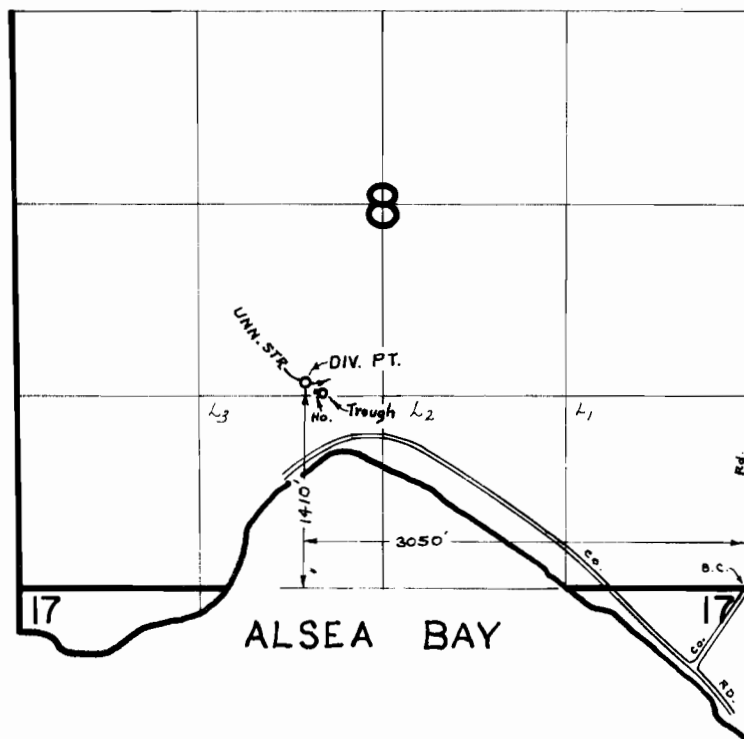

FINAL PROOF SURVEY
UNDER

Application No. 47120 Permit No. 35283
IN NAME OF

BONNIE M. ADKINS

Surveyed AUG. 20, 1974, by D. NORBY