


T.13S. R.11W. W.M.

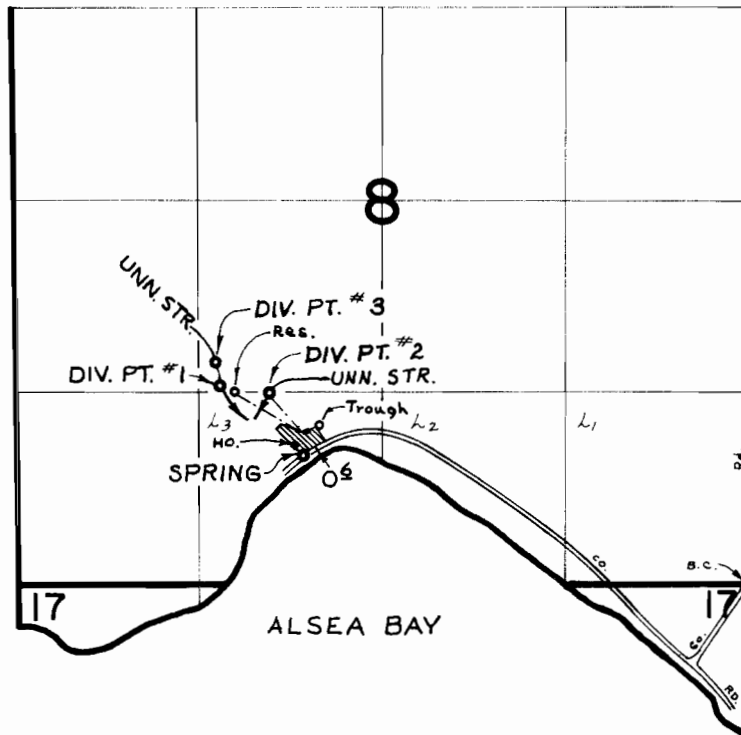

DIV. PTS. LOC: #1 - 1360' N. & 3610' W., #2 - 1310' N. & 3260' W., #3 - 1520' N. & 3640' W., SPRING - 880' N. & 3030' W. ALL FROM S.E. CORNER SECTION 8

FINAL PROOF SURVEY
UNDER

Application No. 47121 Permit No. 35284
IN NAME OF

RICHARD L. TON

Surveyed AUG. 20, 1974, by D. NORBY