


T.12S. R.11W. W.M.

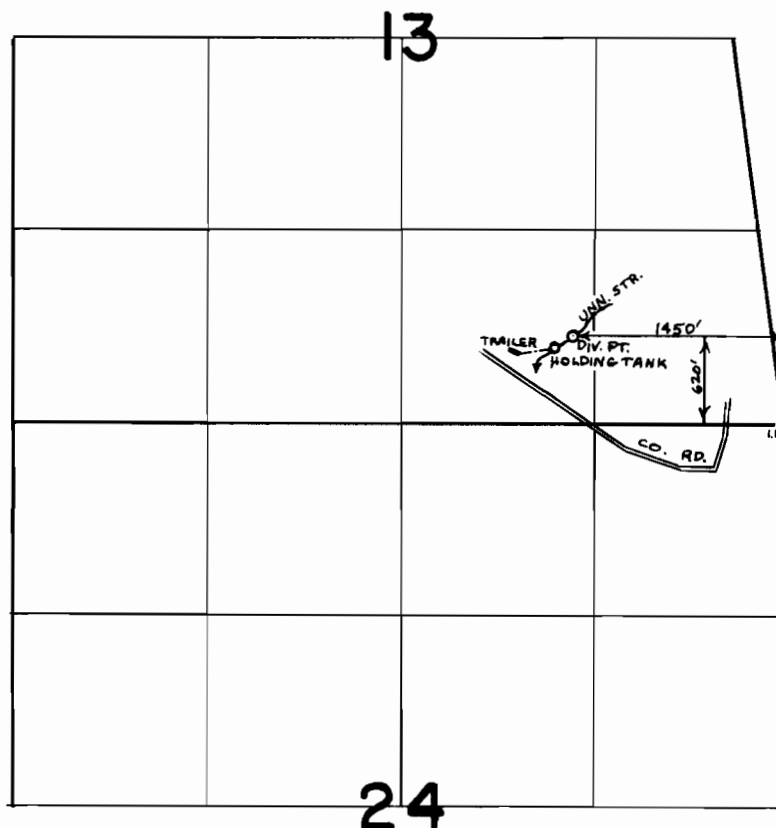

FINAL PROOF SURVEY
UNDER

Application No. 47215 Permit No. 35368
IN NAME OF

HERBERT C. BOYD

Surveyed AUG. 21 1974, by D. NORBY