


T.13S. R.10W. W.M.

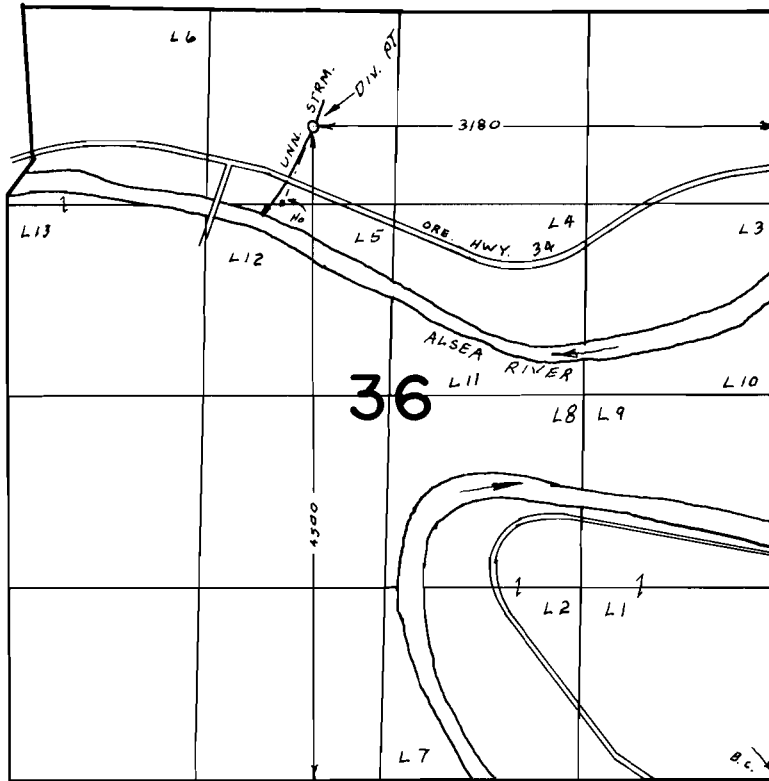

FINAL PROOF SURVEY
UNDER

Application No. 47302 Permit No. 35442
IN NAME OF

IVAN HAMERLYNCK

Surveyed JUN 5 1974, by LH NUNN