


T. 6 S. R. 10 W. W.M.

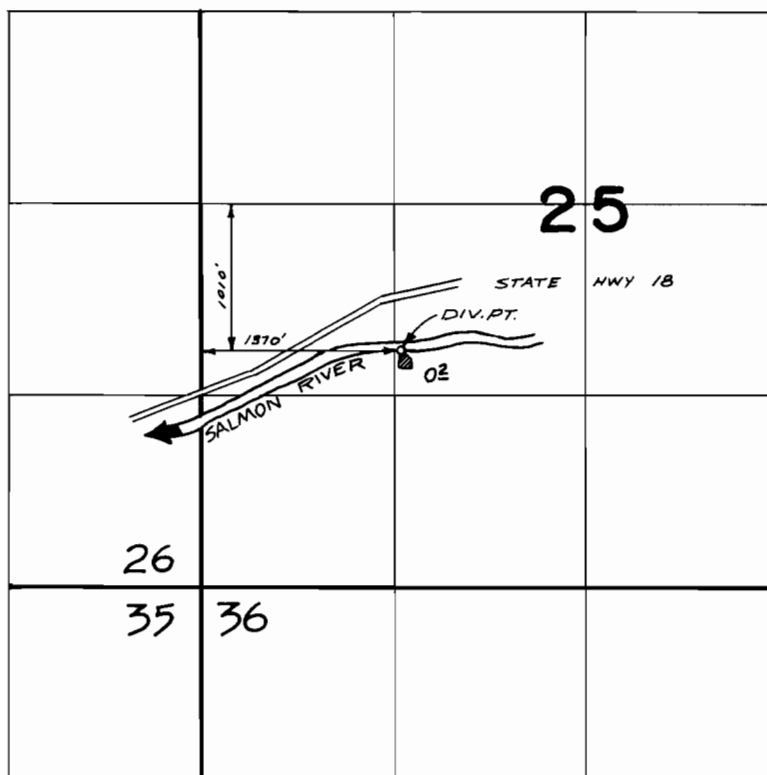

FINAL PROOF SURVEY UNDER

Application No. 48784 Permit No. 36088
IN NAME OF

HAROLD C. WARNER

Surveyed JULY 18 1974, by D. NORBY