


T.58&6S. R.2W. W.M.

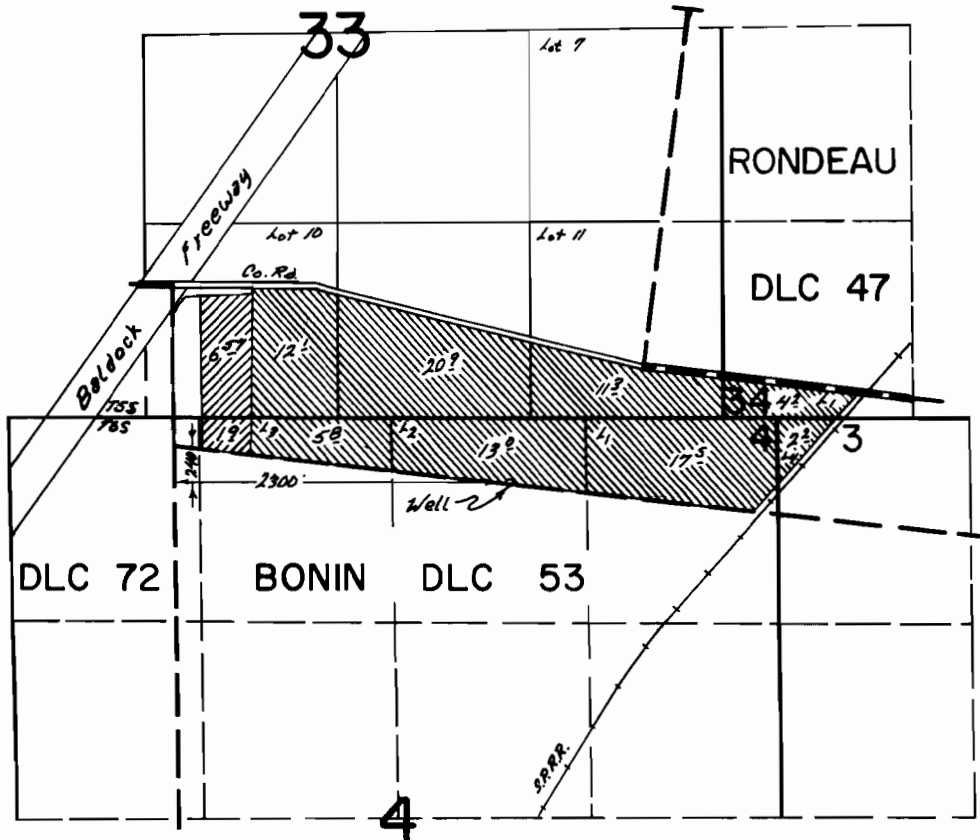

FINAL PROOF SURVEY
UNDER

G-3324

G-2943



Application No. G-3282 Permit No. G-2941

IN NAME OF

JAMES F. BUTSCH

Surveyed July 25 19 78, by R. G. Mucken