


T. 7 S. R. 4 W. W. M.

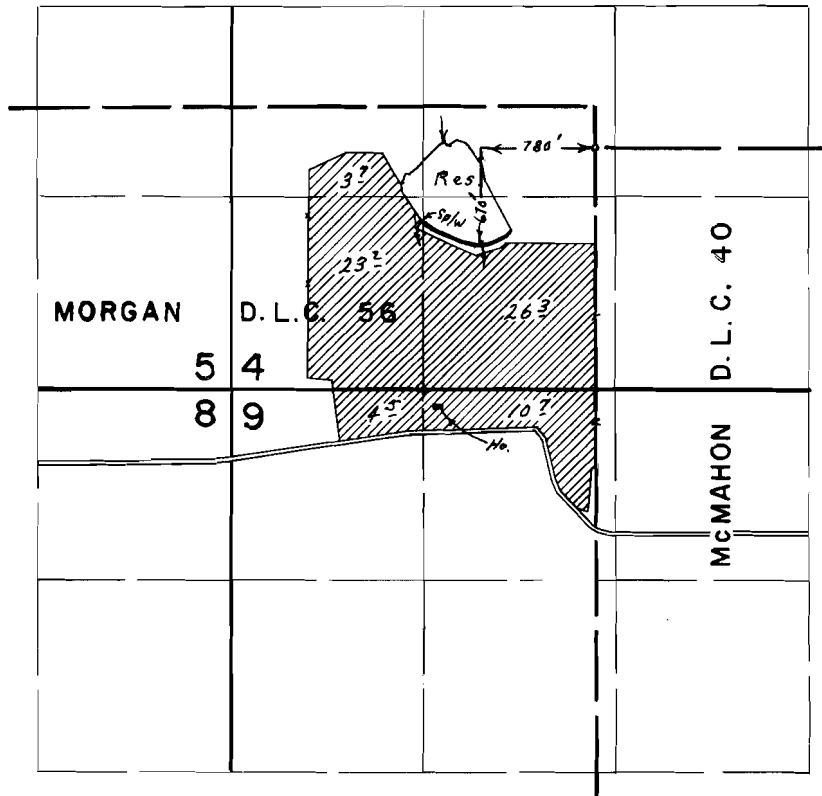

FINAL PROOF SURVEY UNDER

R-43071 R-4903
 Application No. 43072 Permit No. 32181
 IN NAME OF

MARX FARMS INC.

Surveyed April 3, 1972, by L. E. Gould
APRIL 24, 1974 T. J. PAUL