


T.8S. R.5W. W.M.

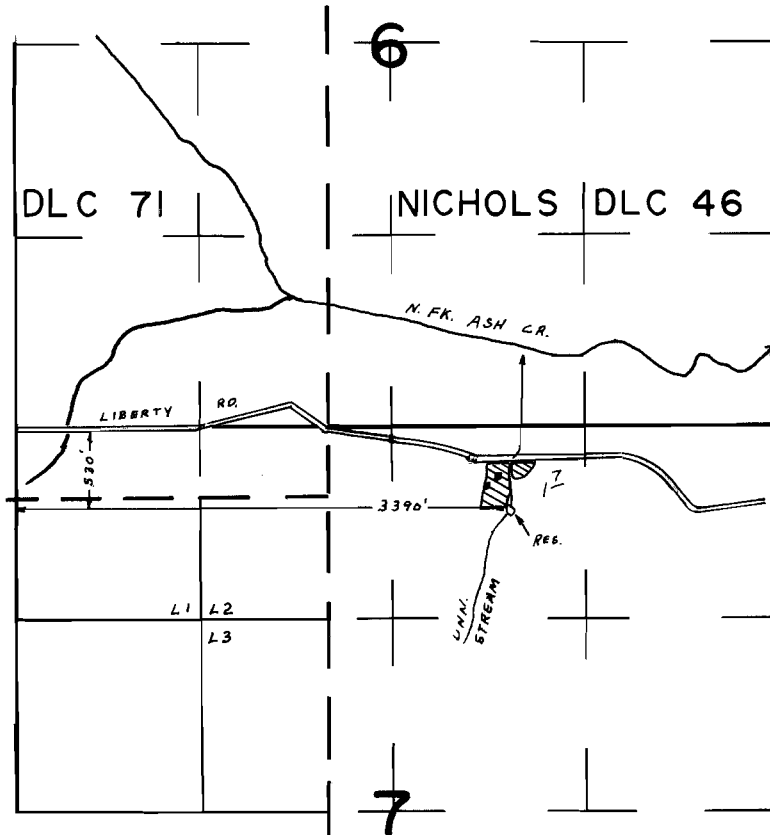

FINAL PROOF SURVEY UNDER

R-47592 R-5620
Application No. 47593 Permit No. 35075
IN NAME OF

Harry & Kevin Eliander

Surveyed AUG 12, 1974, by L.H. NUNN