
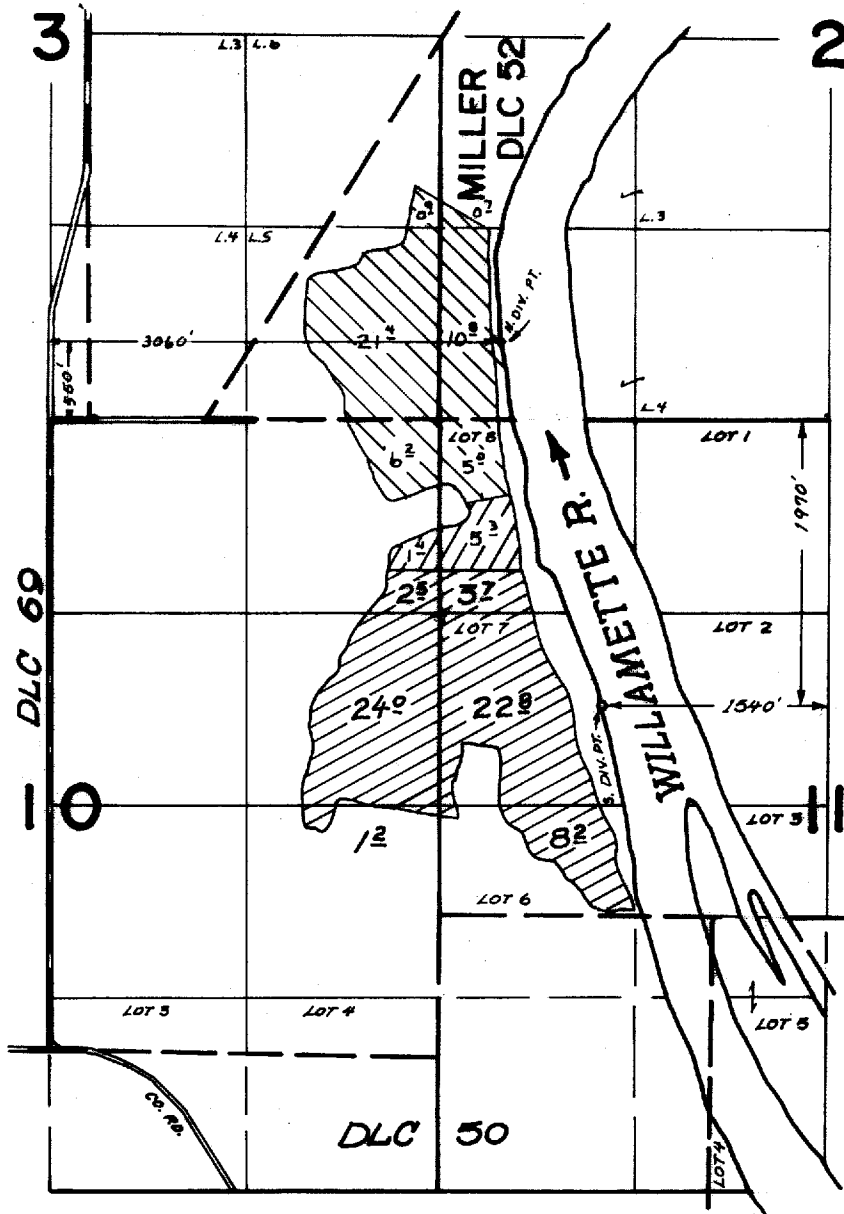
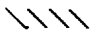



T.10S.,R.4W.,W.M.

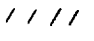

LAND IRRIGATED
 UNDER
 PERMIT 35084
 N. DIV. PT. 
 S. DIV. PT. 
 PERMIT 35085
 S. DIV. PT. 

FINAL PROOF SURVEY UNDER

Application No. ~~46823~~ ⁴⁶⁸²⁴ Permit No. ~~35084~~ ³⁵⁰⁸⁵
 IN NAME OF

LYON & CAMPBELL, INC.

Surveyed JULY 5 1974, by L. A. TOLL
 JULY 17 1974 L. H. NUNN