90694

T.9 & 10S., R.6W., W.M.

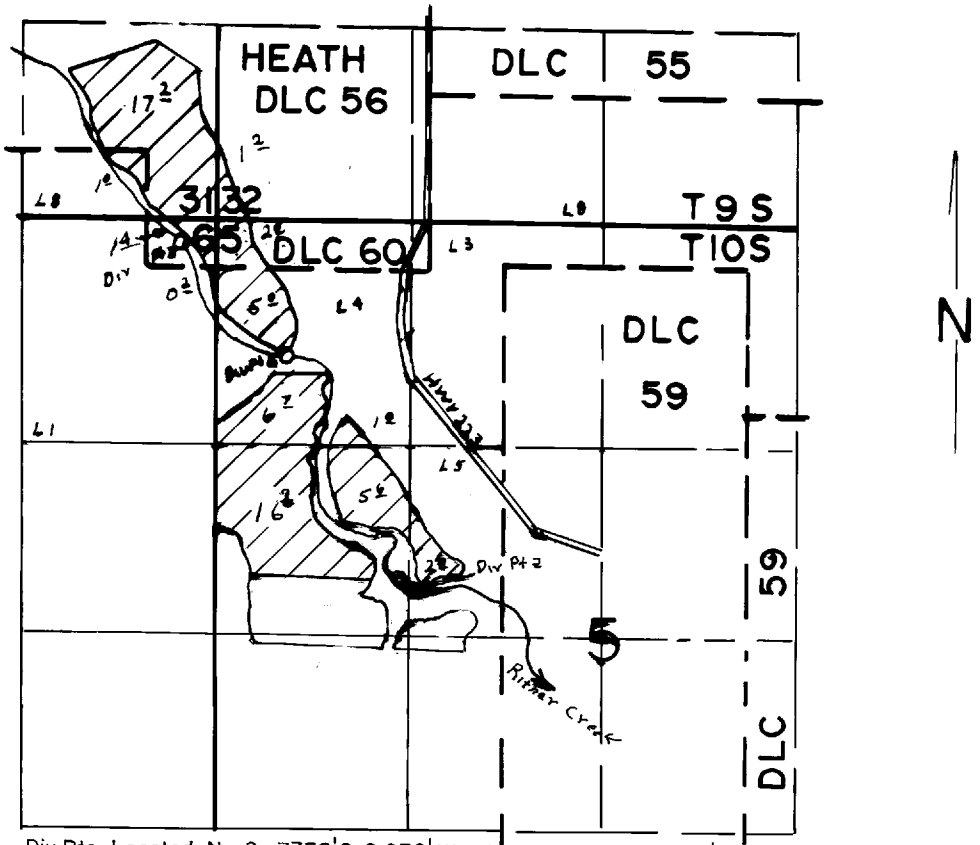

Div. Pts. Located; No. 2-3350'S & 230' W, No 3-1040S & 1700' W.,
No. 4-1820' S. & 950 W., All From SW Corner DLC 55, Sec. 32

SCALE: 1" = 1320'

FINAL PROOF SURVEY
UNDER

Application No. 47132 Permit No. 35213
IN NAME OF

HENRY R. & JOAN G. KAISER

Surveyed JULY 16 1974, by L.H. NUNN

DFP-3LL-179 Revised 7-24-89 DM