


T.7S. R.4W. W.M.

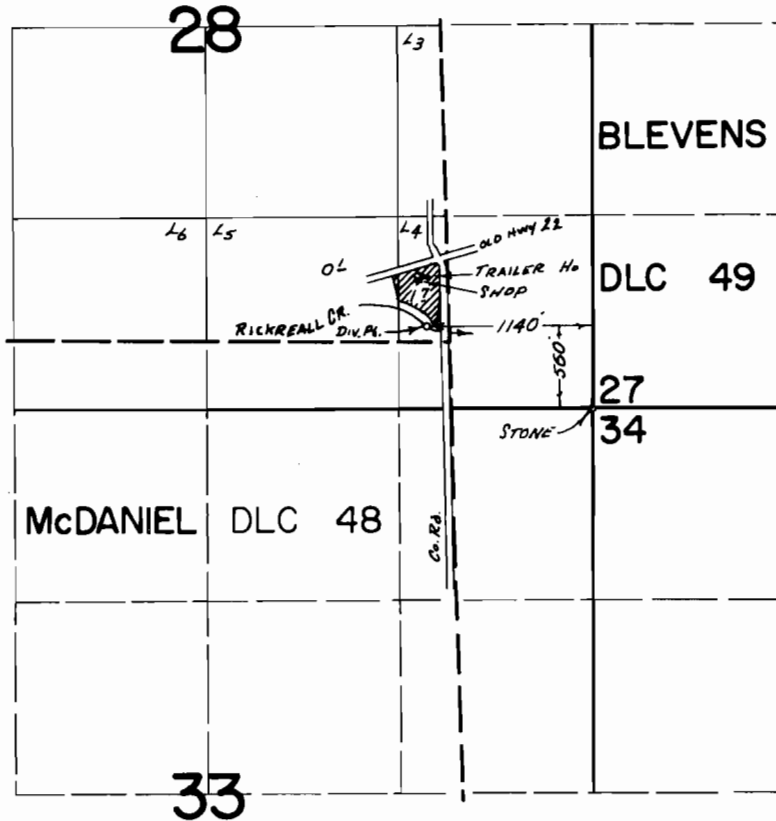

FINAL PROOF SURVEY
UNDER

Application No. 47203... Permit No. 35357...
IN NAME OF

.....LOY WEIGEL.....

Surveyed April 25 1974, by T. J. PAUL.....