


T.6S. R.4W. W.M.

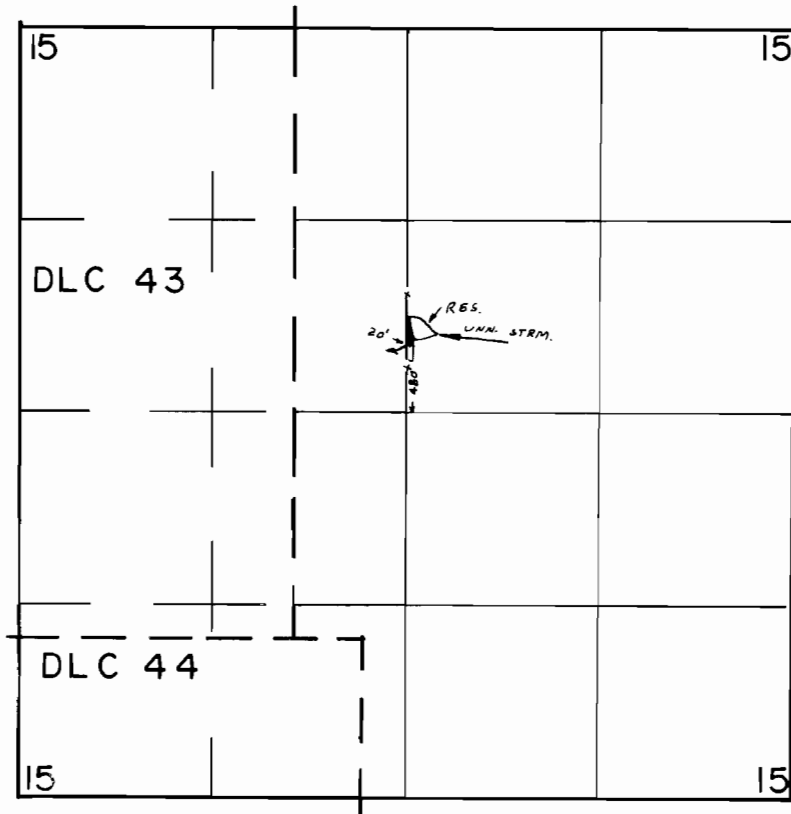

FINAL PROOF SURVEY
UNDER

R-47480 R-5720
Application No. 47481 Permit No. 35564
IN NAME OF

BOB FELDMAN

Surveyed JUN 10 1974, by LH NUNN